


Township N York, Range N XI East Mer. (Mid. Tex)

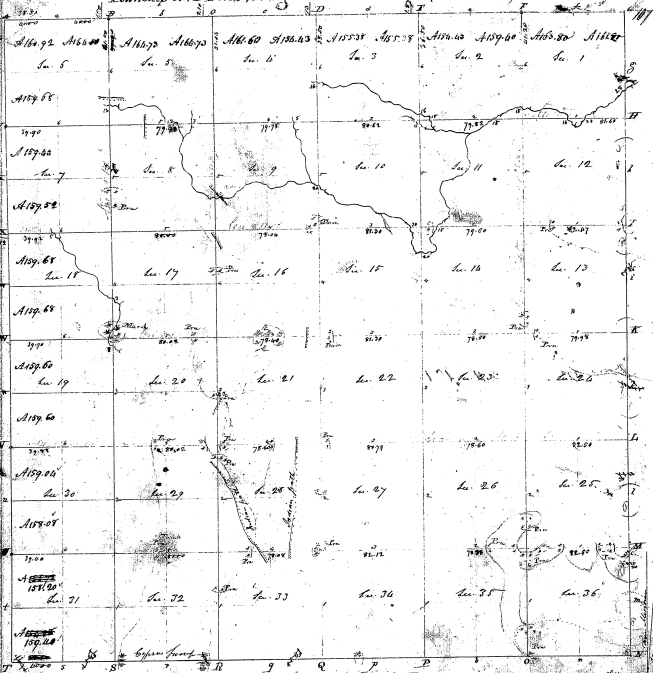

Pursuant to a contract and instructions from Edward ^{W. H.} Tiffin Esquire, Governor of the United States, bearing date the 15 day of December 1866 I have and measured laid out and surveyed the above described township of land; 

Witness my hand
 this 9th day of June 1871

J. Wampler

27-38

37-38