


Township N. ^{III} north, Range N. ^{VIII} East Bos. (Mich. Ter.) 77

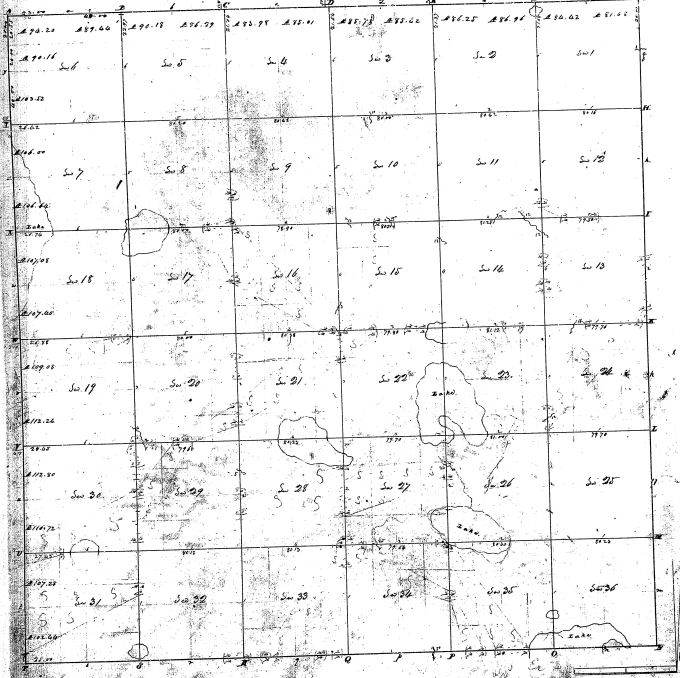

28-29

28-29

D

