


Township N. N North, Range N. VII East 9th Mer. (Mch. Ten)

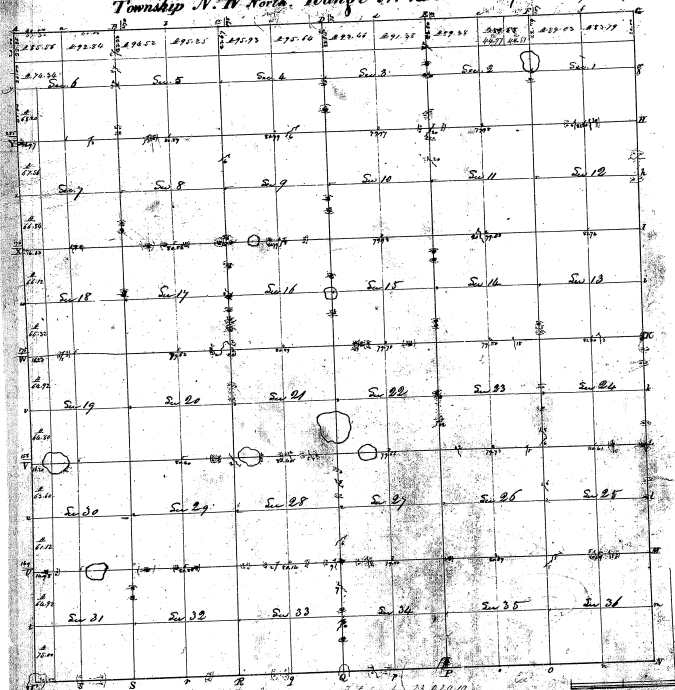

Subscribed and sworn to before me this 23rd day of Nov. 1853

Consistent to a contract with said instructions from Edward J. Fox, Surveyor General of the United States bearing date the 21st day of
 I have examined said plat and being satisfied that the same conform to said instructions and that it has been duly surveyed and
 by the parties and returned as now presented on said plat and that the same have been duly surveyed and returned as now
 presented to the Surveyor General's office - Witness this 23rd day of Nov. 1853

J. Wampler, S. D.

28-27

28-27