# Township N. IV North, Range N. XI West Mer. (Mic. Tor.)

Vol. 25. 180

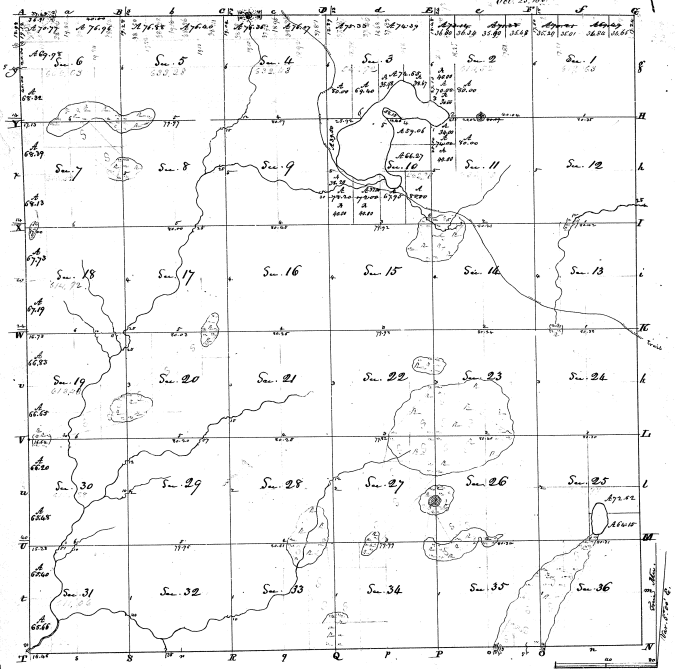


Surveyed in December 1830, & January 1831 by Sylvester Sibley, D.S.

Compt

7-26

## Contents

| Sections | | | Acres | Hundredths | Sections | | | Acres | Hundredths |
|---|---|---|---|---|---|---|---|---|---|
| N½ | NE | 1 | 69 | 69 | E½ | NW | 19 | 80 | |
| S½ | " | " | 80 | | N½ | " | " | 44 | 83 |
| N½ | NW | " | 70 | 21 | E½ | SW | " | 80 | |
| S½ | " | " | 80 | | W½ | " | " | 68 | 65 |
| | S½ | " | 320 | | | S½ | " | 320 | |
| N½ | NE | 2 | 71 | 38 | | Sec. | 20 | 640 | |
| S½ | " | " | 80 | | | | 21 | 640 | |
| N½ | NW | " | 73 | 14 | | | 22 | 640 | |
| S½ | " | " | 80 | | | | 23 | 640 | |
| | SE | " | 160 | | | | 24 | 640 | |
| E½ | SW | " | 80 | | | | 25 | 320 | |
| W½ | " | " | 76 | 00 | N½ | SE | " | 72 | 64 |
| N½ | NE | 3 | 74 | 89 | S½ | " | " | 84 | 15 |
| S½ | " | " | 80 | | | SW | " | 160 | |
| N½ | NW | " | 78 | 33 | | Sec. | 26 | 640 | |
| S½ | " | " | 80 | | | | 27 | 640 | |
| N fr. | SE | " | 74 | 65 | | | 28 | 640 | |
| E½ | SW | " | 69 | 00 | | | 29 | 640 | |
| W½ | " | " | 80 | | E | SE | 30 | 328 | |
| Small fra. | | " | 4 | 15 | E½ | NW | " | 80 | |
| N½ | NE | 4 | 76 | 07 | W½ | " | " | 84 | 20 |
| S½ | " | " | 80 | | E½ | SW | " | 80 | |
| N½ | NW | " | 74 | 36 | W½ | " | " | 65 | 48 |
| S½ | " | " | 80 | | E½ | SE | 31 | 320 | |
| | S½ | " | 320 | | E½ | NW | " | 80 | |
| N½ | NE | 5 | 76 | 60 | W½ | " | " | 67 | 60 |
| S½ | " | " | 80 | | E½ | SW | " | 80 | |
| N½ | NW | " | 74 | 88 | W½ | " | " | 65 | 48 |
| S½ | " | " | 80 | | | Sec. | 32 | 640 | |
| | S½ | " | 320 | | | | 33 | 640 | |
| N½ | NE | 6 | 76 | 96 | | | 34 | 640 | |
| S½ | " | " | 80 | | | | 35 | 640 | |
| N½ | NW | " | 70 | 77 | | | 36 | 640 | |
| S½ | " | " | 67 | 78 | | | | 11,813 | 11 |
| | SE | " | 160 | | | | | 11,664 | 36 |
| E½ | SW | " | 80 | | Total amount of land | | | 149 | 48 |
| W½ | " | " | 64 | 32 | | | | | |
| | S½ | " | 320 | | | | | | |
| E½ | NW | " | 80 | | | | | | |
| W½ | " | " | 68 | 37 | | | | | |
| E½ | SW | " | 80 | | | | | | |
| W½ | " | " | 64 | 13 | | | | | |
| | Sec. | 7 | 640 | | | | | | |
| N½ | NE | 10 | 69 | 06 | | | | | |
| S½ | " | " | 66 | 27 | | | | | |
| N fr. | NW | " | 39 | 50 | | | | | |
| E½ | SE | " | 80 | | | | | | |
| W½ | " | " | 67 | 95 | | | | | |
| E½ | SW | " | 72 | 00 | | | | | |
| W½ | " | " | 78 | 20 | | | | | |
| | NE | 11 | 160 | | | | | | |
| E½ | NW | " | 80 | | | | | | |
| W½ | " | " | 74 | 00 | | | | | |
| | S½ | " | 320 | | | | | | |
| | Sec. | 12 | 640 | | | | | | |
| | | 13 | 640 | | | | | | |
| | | 14 | 640 | | | | | | |
| | | 15 | 640 | | | | | | |
| | | 16 | 640 | | | | | | |
| | | 17 | 640 | | | | | | |
| | E½ | 18 | 320 | | | | | | |
| E½ | NW | " | 80 | 00 | | | | | |
| W½ | " | " | 67 | 79 | | | | | |
| E½ | SW | " | 80 | | | | | | |
| W½ | " | " | 67 | 19 | | | | | |
| | | | 11,079 | 80 | | | | | |

7-26