


Township N. V North, Range N. XI East of the Mer. (Mich. Ter.)

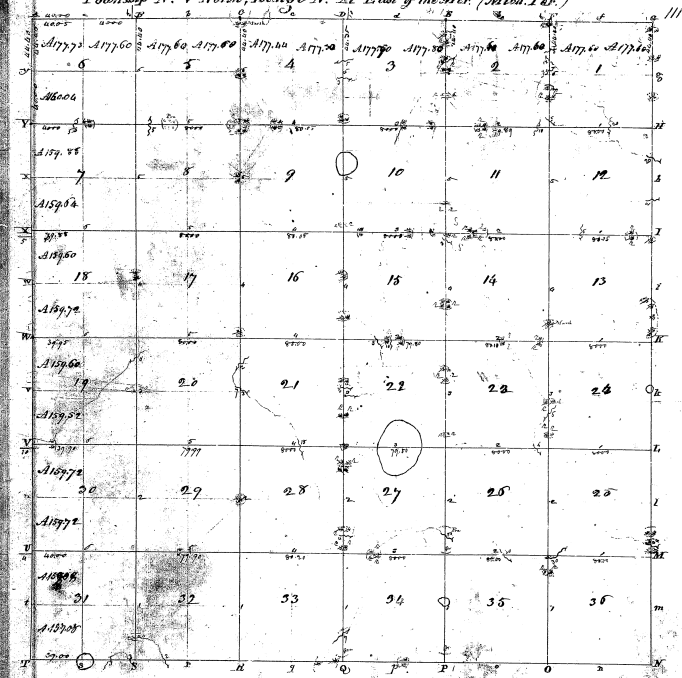

27-22

22-18



