


S. W. Mallard 144-10-26 Mich.

Township N<sup>o</sup> 14 N. Range N<sup>o</sup> 15 West Mer. (Mich.)

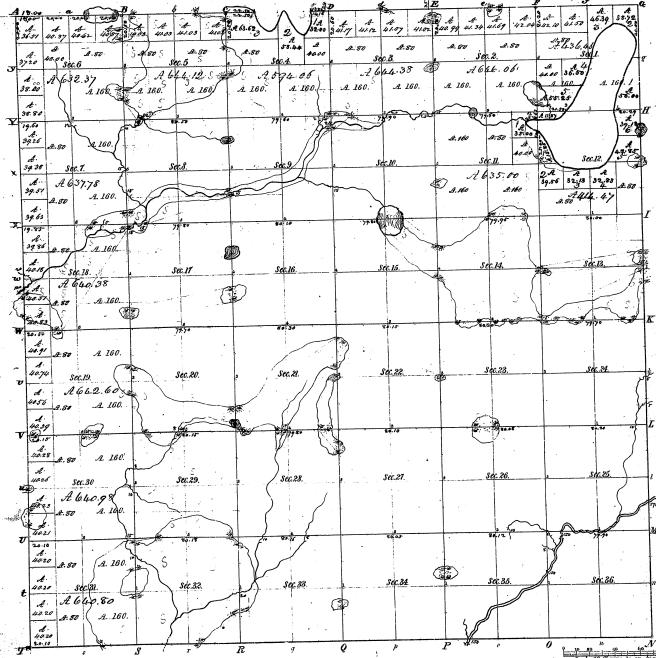



10-26

Total number of Acres 22,069.26


This above Map of Township N<sup>o</sup> 14 N. of Range N<sup>o</sup> 15 West of Principal Meridian, Michigan, is truly conformable to the field notes of the survey thereof on file in the Office, which have been examined and approved.

Surveyor General's Office  
 Eastland, Feb 14 1839

Cont. Copy made 5/18

Robinson