Re-survey

Township No. 22. N. Range No. 1 East. Mer. Mich.

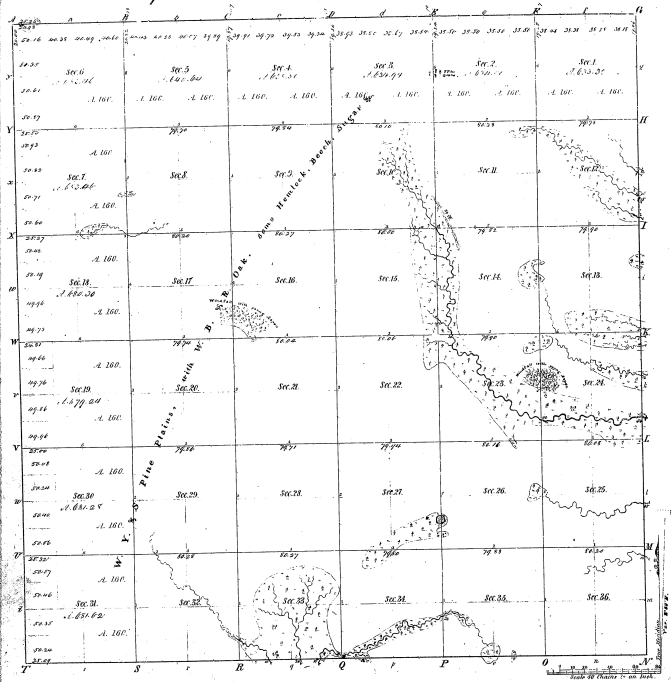

Meanders of					
Posts	Courses	Ths. Lks.	Posts	Courses	Ths. Lks.

21-33

21-33

Total number of Acres: 23270.36

Surveys Designated	By whom Surveyed	Date of Contract	Amount of Surveys	When Surveyed	When plat and ch.d in the Surv.r Gen.l's ass.t
Township lines	Louis Glasson	July 10. 1837	M. Ch.s Lks.	1st qr 1838	
Subdivisions	D. S. Hall	July 14. 1846	60. 23. 93	3rd qr 1846	

The above Map of Township No. 22 North of Range No. 1 East of the Principal Meridian Michigan, is strictly conformable to the field notes of the survey thereof on file in this Office which have been examined and approved.

Surveyor General's Office.
Detroit, July 28th 1846.

Lucius Lyon, Surv.r Gen.l