


Re-survey  
**Township 1<sup>o</sup> 24<sup>n</sup>. Range 1<sup>o</sup> 2<sup>w</sup>. Mer. Mich.**

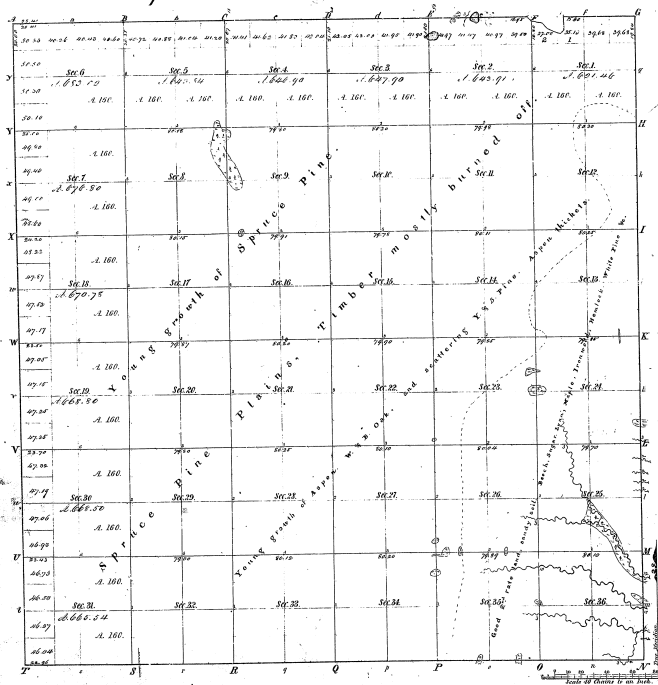

Records of


21-26

92-26

**Total number of acres 25327.65**

Survey designated	By whom surveyed	Date of Contract	Amount of Survey	When Surveyed	How far and in what direction
Township 24 North	James Buchanan	July 10 1847	25 327 65	1852	1852 11 25
Subdivisions	J. M. Kirtland	July 10 1846	25 327 65	1852	1852 11 25

This show 20 of Township 24 North of Range 1 West of the Principal Meridian Michigan, is shelved conformable to the full notes of the survey thereon file in the office and has been examined and approved by me  
 Surveyor General's Office  
 Detroit, West 21 1116  
 Secy. Genl. Spc. Genl.