Re-Survey

Township No. 24 N. Range No. 4 E. Mer. Mich.

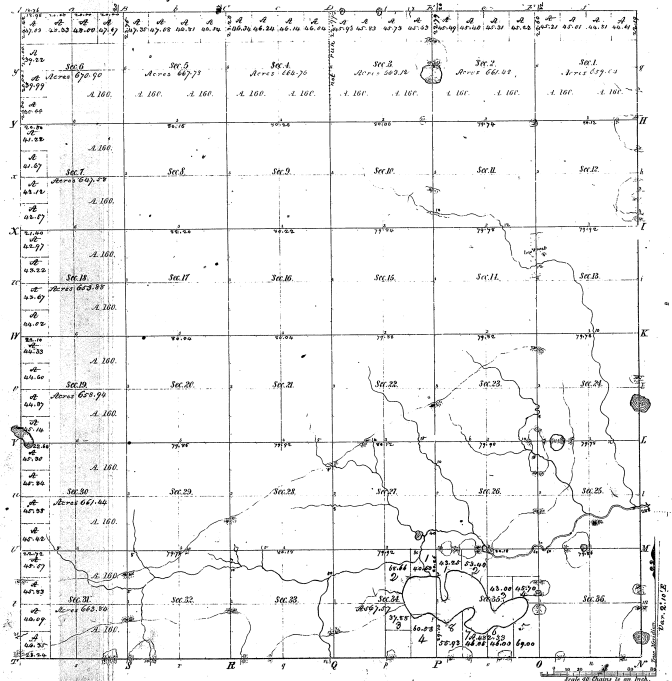

Meanders of

Poole Courses (W.L.)	Poole Courses (W.L.)	Poole Courses (W.L.)

21-28

21-28

Total number of Acres. 22,379.36

Surveys Designated	By Whom Surveyed	Date of Contract	Amount of Surveys	When Surveyed	When Office and ch^n in the Sur^r Genl's ...
Township Lines	Lewis Nelson	July 10. 1837	M. 24. Ch. 08. Lk. 07	9th Sep. 1838	1st Sep. 1839
Subdivisions	John Mullett	Jun. 1. 1842	22. 36. 50	1st Sep. 1842	

(The above Map of Township No. 24 N. of Range No. 4 E. East of the Principal Meridian, Michigan, is strictly conformable to the field notes of the survey thereof on file in this Office, which have been examined and approved.

Surveyor General's Office
Cincinnati, Feb. 14. 1845.

William Johnston
Surv. Genl.