Township N° 46N Range N° 39 W Mer: Mich.

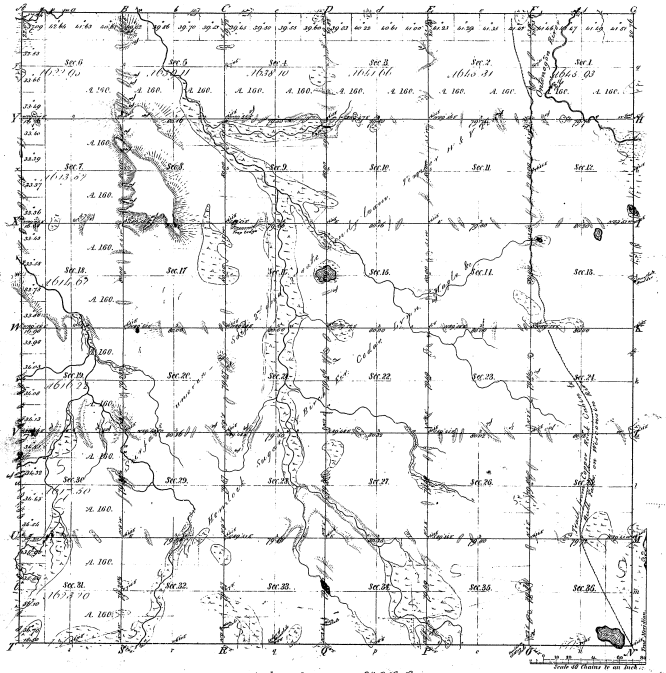

Total number of Acres 22918.12

Surveys Designated	By Whom Surveyed	Date of Contract	Amount of Surveys	When Surveyed	When 2nd sec and 3rd sec the Surr Gen'l use!
Township lines	Austin Bandle	April 27 1857	M. 65 Chs. 11 Lks.	1857	
Subdivisions	F. B Semple	April 18 1861	39 58. 02	2nd Quar 1861	

The above Map of Township No 46 North of Range No 39 West of the Principal Meridian Michigan is strictly conformable to the field notes of the survey thereof on file in this Office, which have been examined and approved.

Surveyor Generals Office. Charles Noble Surr Genl

Detroit April 20 1862.

Meanders of

State Courses	Chs & Lks	State Courses	Chs & Lks	State Courses	Chs & Lks
N 53 E	2nd				

Examined & approved Roy's Copy made

4 3-21