42-21

Township No. 48 N. Range No. 43 W. Mer. Mich.

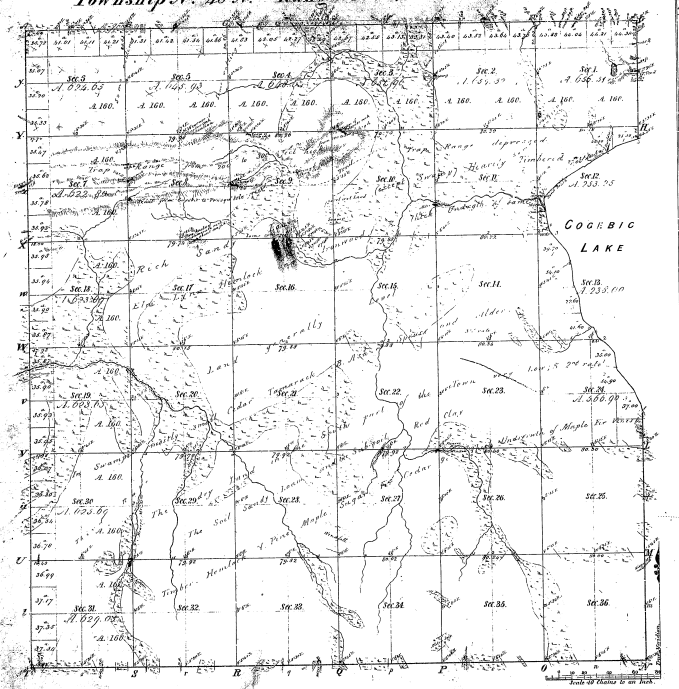

Meanders of									
Posts	Courses	Ch.s Lks.	Posts	Courses	Ch.s Lks.	Posts	Courses	Ch.s Lks.

42-21

Total Meanders
Mile Chains Lks.
3 . 32 . 48

Total number of Acres 22145.04

Surveys Designated	By Whom Surveyed	Date of Contract	Amount of Surveys	When Surveyed	When p.d. ins. and ch.s in the Sur.r Gen.l ass.t
Township Notes	Wm. A. Robertson Sur.r	April 28th 1847	M. Ch.s Lks. 6 01 75	Sep.r 1847	
Subdivisions	Austin Burt	Bond Sum of 1847	62 09 30	Aug.t 28th 1848	

The above Map of Township No. 48 North of Range No. 43 West of the Principal Meridian Michigan, is strictly conformable to the field notes of the survey thereof on file in this Office, which have been examined and approved.

Surveyor Generals Office
Detroit. March 2. 1849

Lucius Lyon, Spr. Genl.

Comd. Cop.