Township N° 49 N. Range N° 38 W. Mer. Mich.

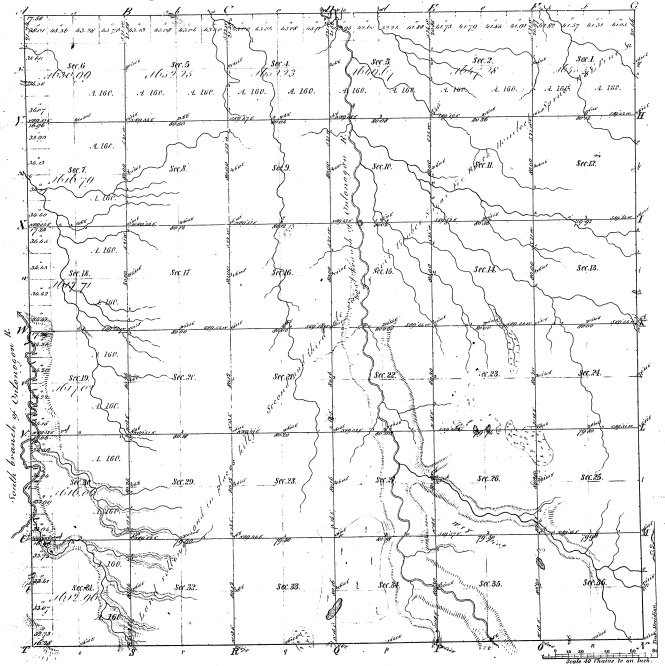

Meanders of

Poste Courses	Chs Lks	Poste Courses	Chs Lks	Poste Courses	Chs Lks
42	0				

43-6

Total number of Acres 23048.71

Surveys Designated	By Whom Surveyed	Date of Contract	Amount of Surveys	When Surveyed	Plats of ten and 48/100 Sec. Cors. rec'd
Township lines	Andrew Ward	April 27 1847	M. 65 Ch.	2nd Quar. 1847	
Subdivisions	Alfonso Cortis	April 10 1851	Sq. 75 82	2. Quar. 1851	

The above Map of Township 49 North of Range 38 West of the Principal Meridian Michigan is strictly conformable to the field notes of the surveys thereof on file in this Office, which have been examined and approved.

Surveyor Generals Office. Detroit Dec. 5 1851

Charles Whipple
Surv'r Gen'l