Township N° 49 N. Range N° 42 W. Mer. Mich.

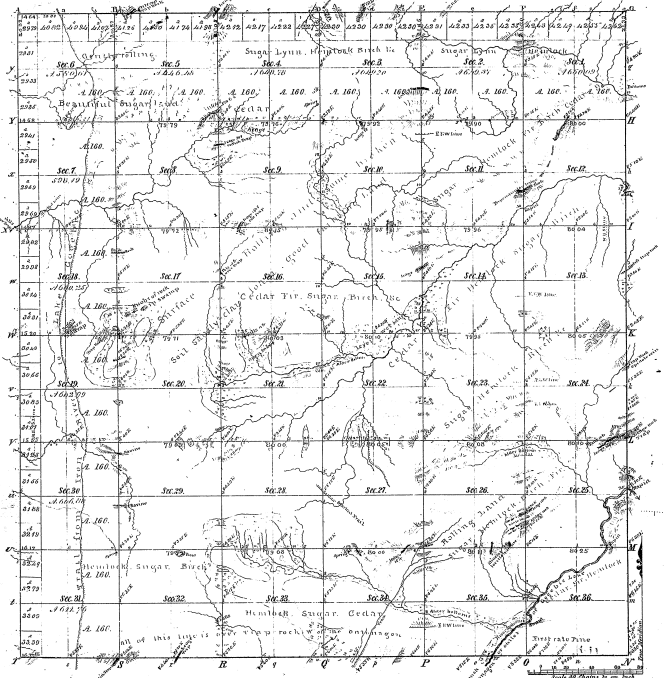

Total number of Acres 22,644.66

Surveys assignated	By Whom Surveyed	Date of Contract	Amount of Surveys	When Surveyed	When & to what date the Surr Gen.l was rec.d
Township lines	Wm A Whistler Deputy	April 27 1847	M. 78 Chs. 50	Sept. & Oct. 1847	
Subdivisions	Mem. Deputy	Do. do. do.	59. 60. 24	Do. do. do. 1847	

The above Map of Township 49 North of Range N° 42 West of the Principal Meridian in Michigan is strictly conformable to the field notes of the survey thereof on file in this Office, which have been examined and approved.

Surveyor Generals Office
Detroit June 27, 1849

Lucius Lyon, Surr Genl

Meanders of

Posts	Courses	Dist.ce	Posts	Courses	Dist.ce	Posts	Courses	Dist.ce

42-8