Township No. 49 N. Range No. 43 W. Mer. Mich.

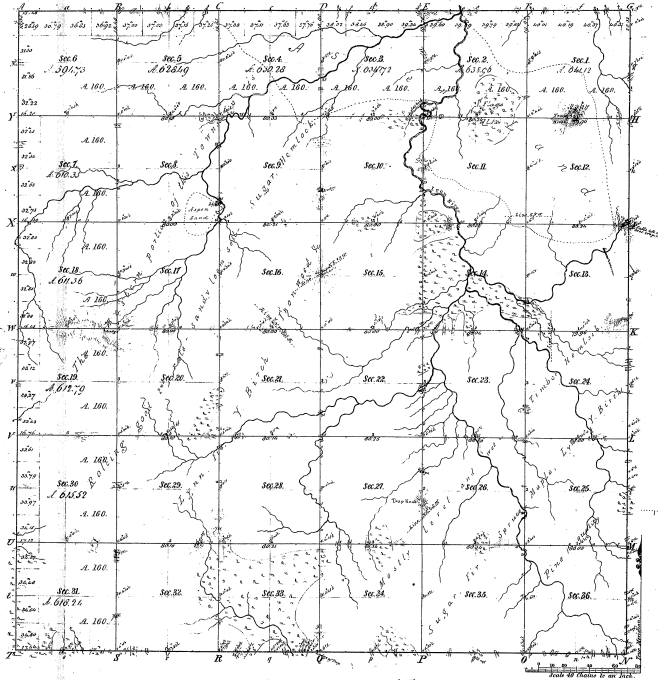

Meanders of								
Posts	Courses	Ch. Lk.	Posts	Courses	Ch. Lk.	Posts	Courses	Ch. Lk.

42-9

42-9

Total number of Acres: 22 836.50

Surveys Designated	By Whom Surveyed	Date of Contract	Amount of Surveys	When Surveyed	When p.d for and ch.d in the Surv. Gen.l Ofc.
Township lines	John V. Austin Bust	April 27 1847	M. 66 lks. 77 " 74	3d qr. 1847	
Subdivisions	William Bust	Hand Tract 1848	52 " 62 " 00	2nd & 3d qr. 1848	

The above Map of Township No. 49 North of Range No. 43 West of the Principal Meridian Michigan is strictly conformable to the field notes of the survey thereof on file in this Office, which have been examined and approved.

Surveyor General's Office.
Detroit Jany. 27, 1849

Lucius Lyon, Surv. Genl.