Township No. 49 N. Range No. 44 W. Mer. Mich.

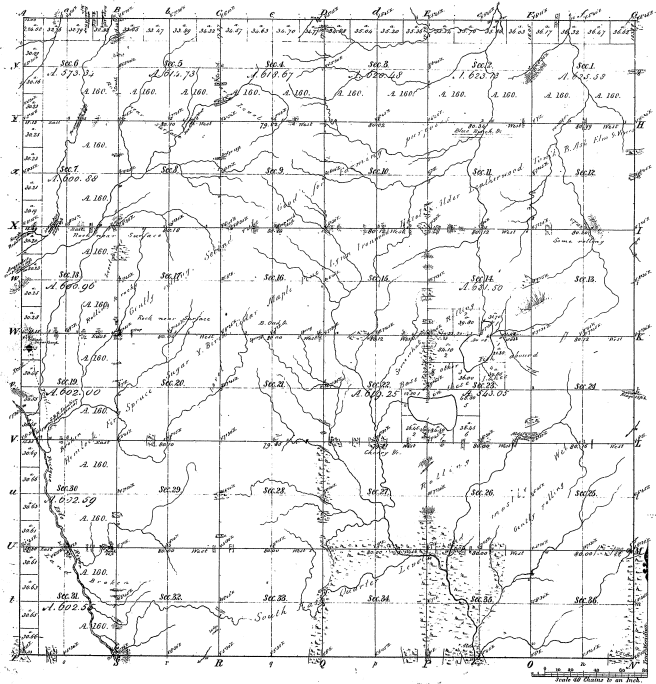

Meanders of

Pools	Courses	100 Links	Pools	Courses	100 Links	Pools	Courses	100 Links

42-10

Total number of Acres 22558.71

Surveys Designated	By Whom Surveyed	Date of Contract	Amount of Surveys	When Surveyed	When the east & west lines of the Tier Nos. were run
Township lines	Milton A. Buell Jr.	Aug. 1847	W. 68 33 00	Sept. 1847	
Subdivisions	Milton A. Buell Jr. William M. Buell	Passed Inspection	11 68 34	August 1848	

The above Map of Township No. 49 North of Range No. 44 West of the Principal Meridian Michigan, is strictly conformable to the field notes of the survey thereof on file in this Office, which have been examined and approved.

Surveyor Generals Office
Detroit Nov. 27. 1849

Lucius Lyon, Surv. Gen.