Township N.º 49 N. Range N.º 48. W. Mer. Mich.

42-14

LAKE SUPERIOR.

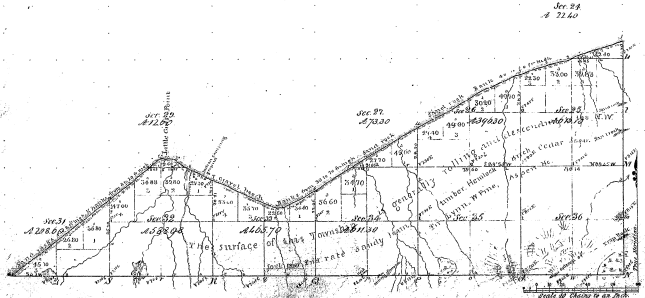

Total number of Acres 4274.21

Surveys Designated.	By Whom Surveyed.	Date of Contract.	Amount of Surveys. M. Chs.	When Surveyed.	When Accepted by the Surveyor Genl.
Township lines.	Wm. H. Pelcock & Assistants	January 8th 1847	S. 26 25	Sept. 30th 1847	
Subdivisions.	William Ives	Dated 9th May 1848	16 27 20	Sept. 30th 1848	

The above Map of Township 49 N. of Range 6 W. of the Principal Meridian Michigan is strictly conformable to the field notes of the survey thereof on file in this Office, which have been examined and approved.

Surveyor Genl's Office
Detroit January 16th 1849