Township N.° 50 N. Range N.° 38 W. Mer. Mich.

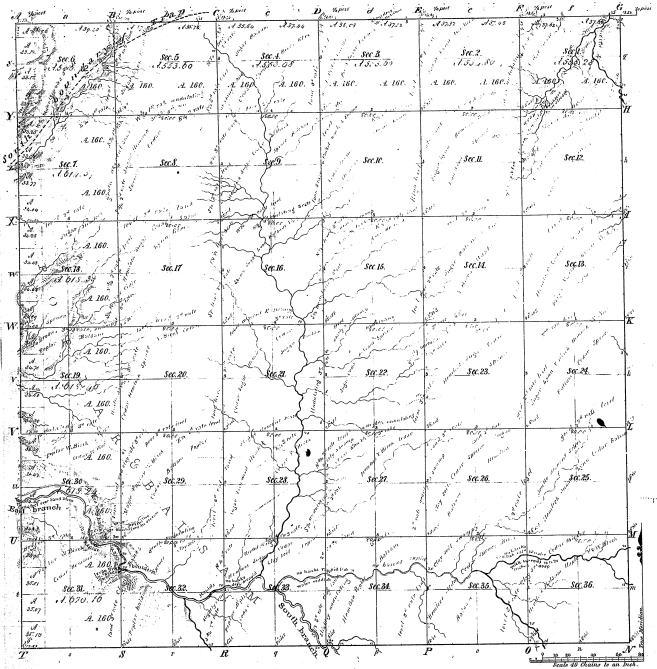

Total number of Acres. 22397.78

Meanders of					
Poste	Courses	⟨E.⟩⟨W.⟩	Poste	Courses	⟨E.⟩⟨W.⟩	Poste	Courses	⟨E.⟩⟨W.⟩

Surveys Designated	By Whom Surveyed	Date of Contract	Amount of Surveys	When Surveyed	When Approved and to the Surveyor Gen.ˡ Office
Township lines	Alvan W. Stark	March 27 1846	M. C. Lks. 21 00 00	2 qr. 1847	
Subdivisions	A. W. Harrison	March 5 1847	21 00 00	2 qr. 1847	

The above Maps of Township N.° 50 North of Range N.° 38 West of the Principal Meridian Michigan, is strictly conformable to the field notes of the survey thereof on file in this Office, which have been examined and approved.

Surveyor Generals Office
Detroit Mich.ᵍᵃ 1848

Lucius Lyon
Surv.ʳ Genl.

43-3