


Township N^o 50 N. Range N^o 40 W. Mer. Mich.

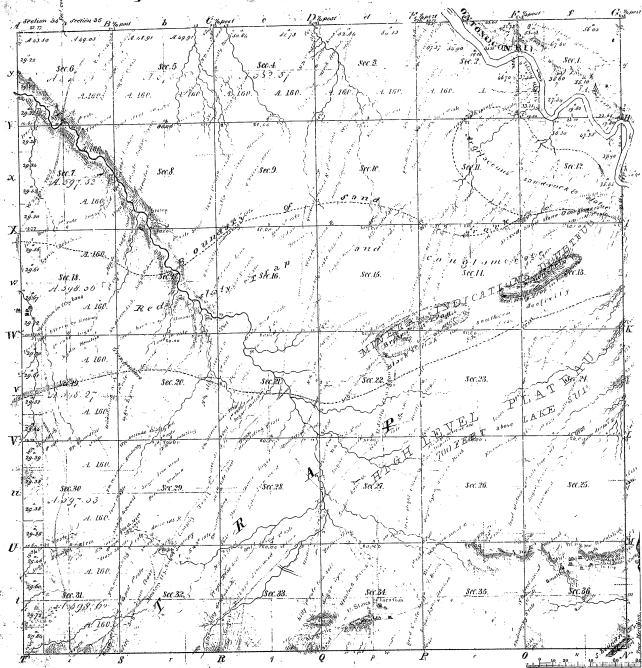

Machinery of		Total Acres		Total Acres	
Public Lands	Private	Public Lands	Private	Public Lands	Private
113	1				

43-1

Total number of Acres 2233.8.511					
Survey Designated	By Whom Surveyed	Date of Contract	Amount of Survey	Area Surveyed	Map for and by
Township	State	April 22 1857	16.87.16	2233.8.511	
Subdivisions	J. R. Rogers	May 22 1857	65.1.26	2233.8.511	

The above map of Township N^o 50 North of Range N^o 40 West of the Principal Meridian Michigan is a strictly conformable to the field notes of the survey thereon file in the office and has been examined and approved.

Lucius Lyon Surveyor
 Detroit March 28th 1858