T. 51 N., R. 41 W. | T. 51 N. R. 40 W.

Township No. 50 N. Range No. 41 W. Mer. Mich.

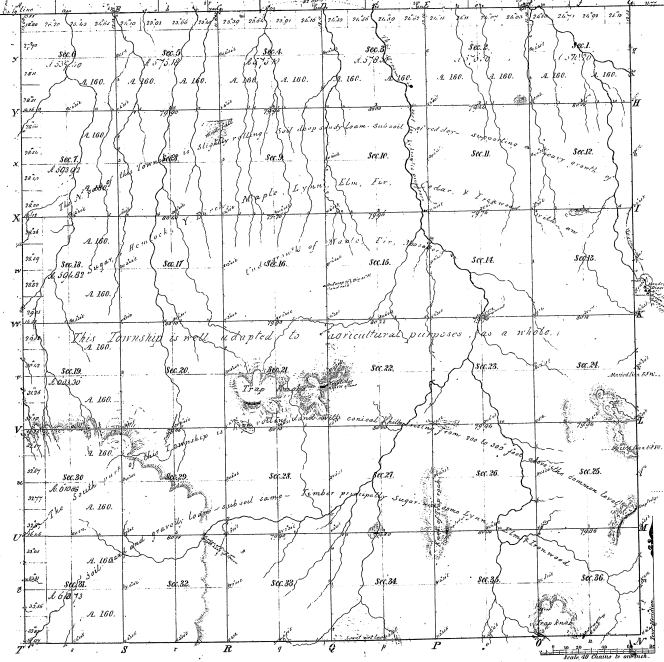

Meanders of								
Posts	Courses	Ch. Lk.	Posts	Courses	Ch. Lk.	Posts	Courses	Ch. Lk.

42-6

Total number of Acres 22 440.31

Surveys Designated	By Whom Surveyed	Date of Contract	Amount of Surveys	When Surveyed	When Sup. Gen. ch. in the Surv. Gen. to acct.
Township lines	Wm. A. Austin Pres.	April 27 1847	M. Ch. Lks. 11 69 49	3d qr. 1847	
Subdivisions	Austin Bank	Bond Sept 9 1848	59 14 75	2nd qr. 1848	

The above Map of Township No. 50 North of Range No. 41 West of the Principal Meridian Michigan is strictly conformable to the field notes of the survey thereof on file in this Office, which have been examined and approved.

Surveyor Generals Office
Detroit March 3d 1849

Lucius Lyon, Spr. Genl.

