42-5

T.51 N. R.42 W. | T.51 N. R.41 W.

Township No. 50 N. Range No. 42 W. Mer. Mich.

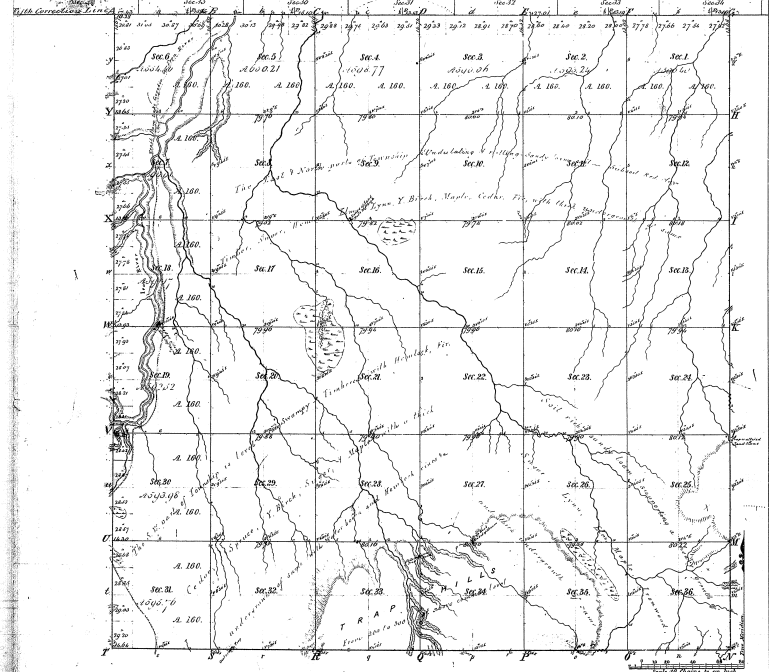

Meanders of									
Posts	Courses	Ch.s Lk.s	Posts	Courses	Ch.s Lk.s	Posts	Courses	Ch.s Lk.s

Total number of Acres 27406.58

Surveys designated	By Whom Surveyed	Date of Contract	Amount of Surveys	When Surveyed	Which of the Surv. Gen.l are in the Surv. Gen.l's Office
Township lines	Jno. A. L. Austin Dept.	April 24 1847	Ch.s Lk.s	2d qr. 1848	
Subdivisions	" Austin Dept.	Renewed 24 Aug. 1848	55 21 56	2nd qr. 1848	

The above Map of Township No. 50 North of Range No. 42 West of the Principal Meridian Michigan is strictly conformable to the field notes of the survey thereof on file in this Office, which have been examined and approved.

Surveyor Generals Office.
Detroit, March 9 1849 Lucius Lyon, Surv. Genl.

Copy forwarded
Rep. approved