T.51 N. R.43 W. T.51 N. R.42 W.

Township. N°50 N. Range . N°43 W. Mer. Mich.

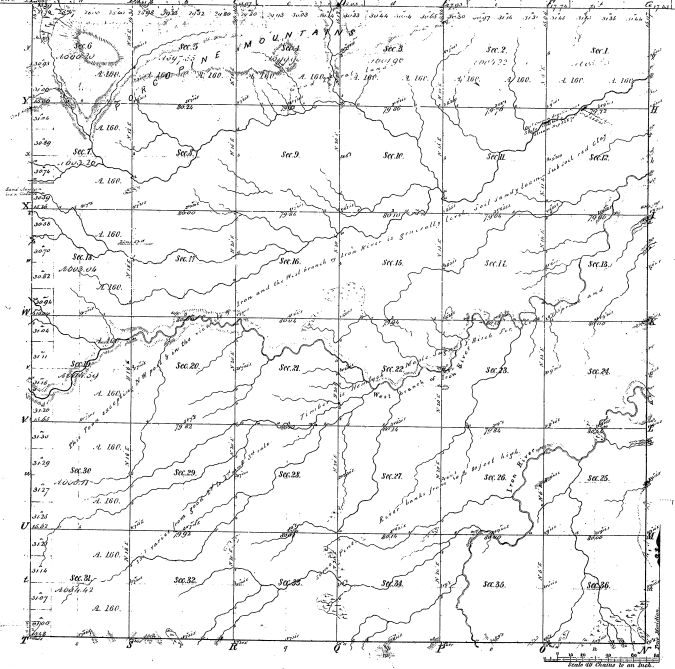

Meanders of

Post Courses	Rec'd	Post Courses	Rec'd	Post Courses	Rec'd

42-4

Total number of Acres 22880.94

Surveys Designated	By Whom Surveyed	Date of Contract	Amount of Surveys	When Surveyed
Township. Lines	Wm. Austin Theed	April 17 & 24 1846	41 68 Lks	1846
Subdivisions	Austin Theed	Nov. 28 1846	579 - 62 - 70	1847

Meanders of the Lakes and Rivers in the Surveys

The above Map of Township N°50 North of Range N°43 West of the Principal Meridian Michigan is strictly conformable to the field notes of the survey thereof on file in this Office, which have been examined and approved.

Surveyor Generals Office.
Detroit March 9 1849

Lucius Lyon Surv. Gen.