


Township N^o 51 N. Range N^o 37 W. Mer. Mich.

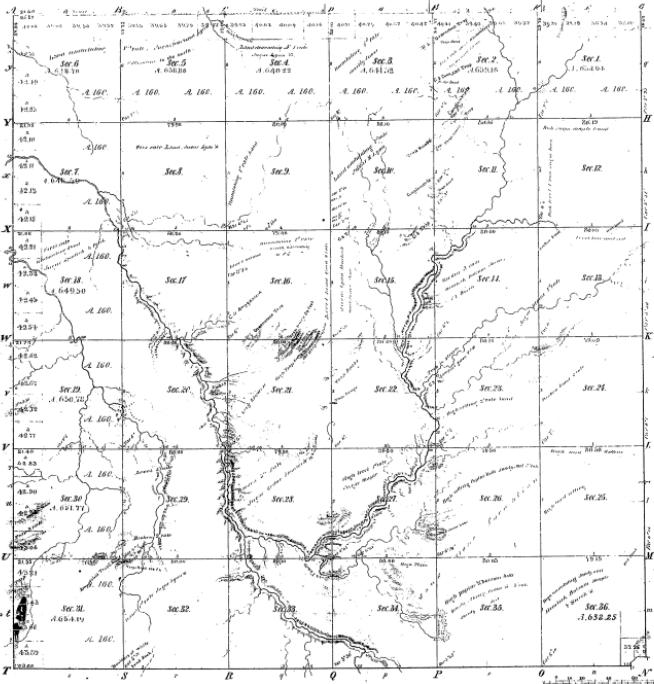

Surveyor Designated	By whom Surveyed	Date of Contract	Amount of Survey	When Surveyed	Where Surveyed	Remarks made by Surveyor or his Agent
Township Lines	Jno. A. Blod.	Aug. 25 th 1858	Pl. 25 1/4	Sept. 1858		
Subdivisions	James H. Sherman (late H. H. H.)	Sept. 28 th 1858	66. 25 1/4	Sept. 28, 1858		

Total number of Acres 23,169.23

The above Map of Township N^o 51 North of Range N^o 37 West of Principal Meridian Michigan is fully conformable to the field notes of the survey thereof on the spot which have been examined and approved Surveyor General's Office
Detroit September 1st 1859

41-37