Township. N.o 51 N. Range N.o 5 W. Mer. Mich.

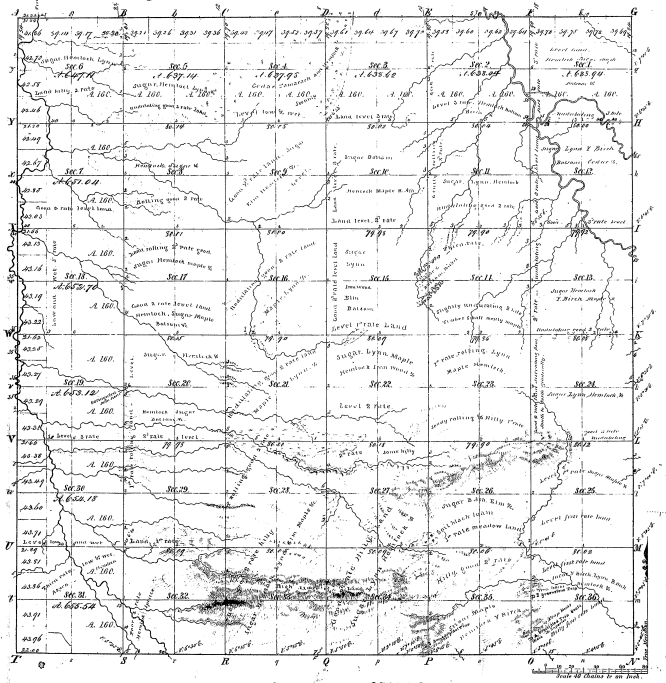

Meanders of

Pond's	Courses &c	Dist.	Pond's	Courses &c	Dist.	Pond's	Courses &c	Dist.
1-11								

41-36

Total number of Acres. 25104.81

Surveys Designated	By Whom Surveyed	Date of Contract	Amount of Surveys	When Surveyed	When Approved and Rec'd in the Surveyor Gen.l's Office
Township lines	Jno. Collins	June 21 1844	M. Ch. Lks. 71 79 92	1845	
Subdivisions	Hoyer & Hollands	April 29 1846	61 07 39	1846	

The above Map of Township N.o 51 North, of Range N.o 5 West of the Principal Meridian Michigan, is strictly conformable to the field notes of the survey thereof on file in this Office, which have been examined and approved.

Surveyor Generals Office.

Detroit Octo 16. 1847

Lucius Lyon Surv.r Gen.l