Township No. 52 N. Range No. 39 W. Mer. Mich.

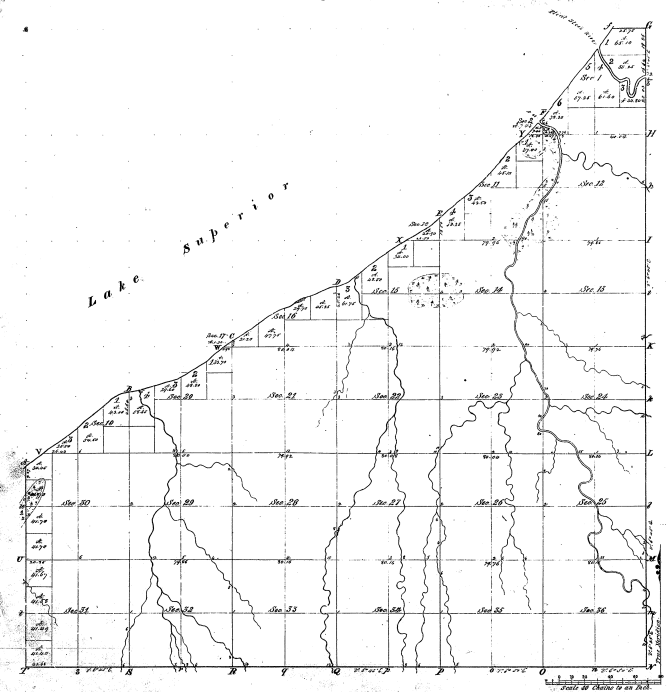

Meanders of					
Pass. Courses	Ch. Lk.	Pass.	Courses	Ch. Lk.	
41-28					

41-28

Total number of Acres 14471.69

Survey Designated.	By Whom Surveyed.	Date of Contract.	Amount of Surveys. M. Ch. Lk.	When Surveyed.	When Charged to the Surv. Genl. &c.
Township lines.	Wm. A. Burt	June 5. 1844		3rd qr. 1845	
Subdivisions.		No contract	47. 19. 39		

The above Map of Township No. 52 North of Range No. 39 West of the Principal Meridian Michigan is strictly conformable to the field notes of the survey thereof on file in this Office, which have been examined and approved.

Surveyor General's Office
Detroit, March 9. 1846

Lucius Lyon, Sur. Genl.