Resurvey

Township No. 17 N. Range No. 8 W. Mer. Mich.

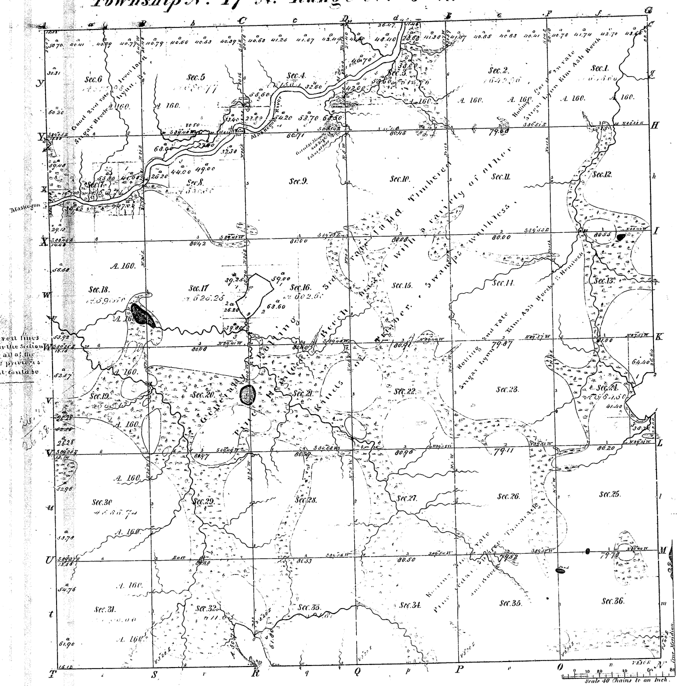

Note. The red lines drawn near the Section lines, are all of the lines of the previous Survey that could be found.

Meanders of								
Posts	Courses	Chs. Lks.	Posts	Courses	Chs. Lks.	Posts	Courses	Chs. Lks.

12-16

12-16

Total number of Acres 22876.23

Surveys Designated	By Whom Surveyed	Date of Contract	Amount of Surveys M.	Chs.	Lks.	When Surveyed	When pd. for and chd. in the Sur. Gen.ls acc.t
Township lines	[illegible]	[illegible] 12th 1837	23.	73	35	Dec 1837	
Subdivisions	Geo. W. Kelly	Sep. 16 1837	81.	16	25	[illegible] 1839	
[illegible]	Orson Lyon	April 14 1847	71.	32.	27	[illegible] 1847	

The above Map of Township No. 17 North of Range No. 8 West of the Principal Meridian Michigan is strictly conformable to the field notes of the survey thereof on file in this Office, which have been examined and approved.

Surveyor General's Office.
Detroit Feby 21st 1848

Lucius Lyon,
Sur. Genl.