12-10

Re-survey

Township No. 18 N. Range No. 7 W. Mer. Mich

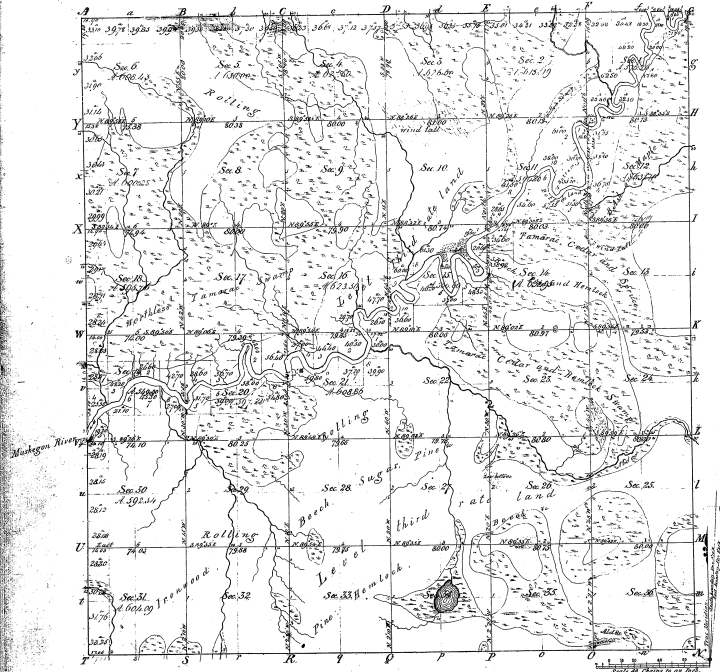

Meanders of				
Posts	Courses	Chs. Lks.	Posts	Courses

Note — No old lines found in this township.

Total meanders 27.13.32

Total number of Acres 22.403.66

Surveys Designated.	By Whom Surveyed.	Date of Contract.	Amount of Surveys M. Chs. Lks.	When Surveyed.	When Charged in the Surr. Genl's acct.
Township lines.	John Hodgson	April 10th 1847	11.76.30	1827	
Meanders	Orson Lyon	April 14th 1847	27.13.32	2nd qr. 1848	
Subdivisions.	Orson Lyon	April 14th 1847	58.77.44	2nd qr. 1848	
			86.50.76		

of the resurvey

The above Map of Township No. 18 North of Range No. 7 West of the Principal Meridian Michigan is strictly conformable to the field notes of the survey thereof on file in this Office, which have been examined and approved.

Surveyor Generals Office,
Detroit Aug. 11. 1848

Lucius Lyon, Surr. Genl.