Resurvey

Township No. 19 N. Range No. 7 W. Mer. Mich

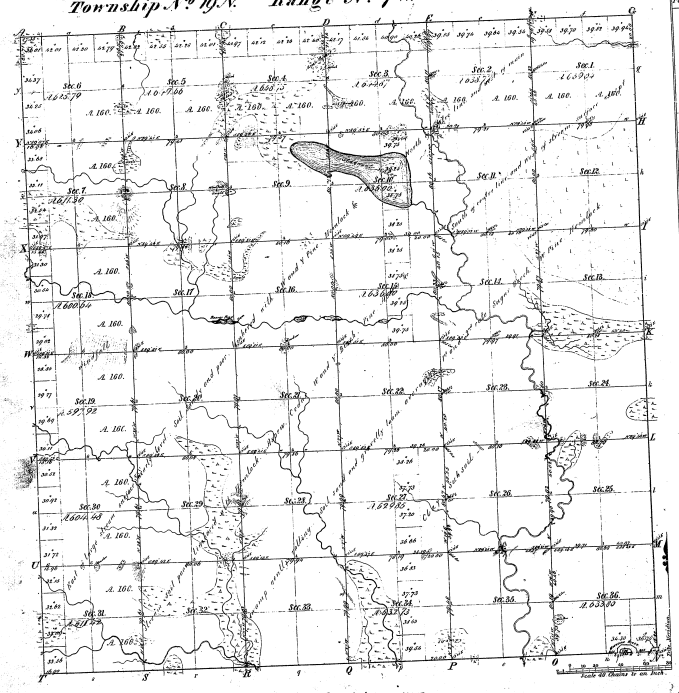

Meanders of								
Posts	Courses	Ch. Lk.	Posts	Courses	Ch. Lk.	Posts	Courses	Ch. Lk.

Note - Lots shaded Yellow sold prior to the resurvey.

12-7

12-7

Total number of Acres. 22841.02

Surveys Designated	By Whom Surveyed	Date of Contract	Amount of Surveys	When Surveyed	When Plat and ch.d in the Surv. Gen.l Ofc.
Township lines	John Hodgson	January 13th 1837	31 36 00	1st Quar. 1837	
Subdivisions	Francis Colman	April 29th 1856	39 58 76	3rd Quar. 1856	

The above Map of Township No. 19 N. of Range No. 7 West of the Principal Meridian Michigan is strictly conformable to the field notes of the survey thereof on file in this Office, which have been examined and approved.

Surveyor General's Office
Detroit December 16th 1856

Leander Chapman
Sur. Gen.l

Com.d Copy made
Rec.d Copy made