


Township N.º 10 N., Range N.º 0 West Mer. (Mich.)

July 19 91

11-5

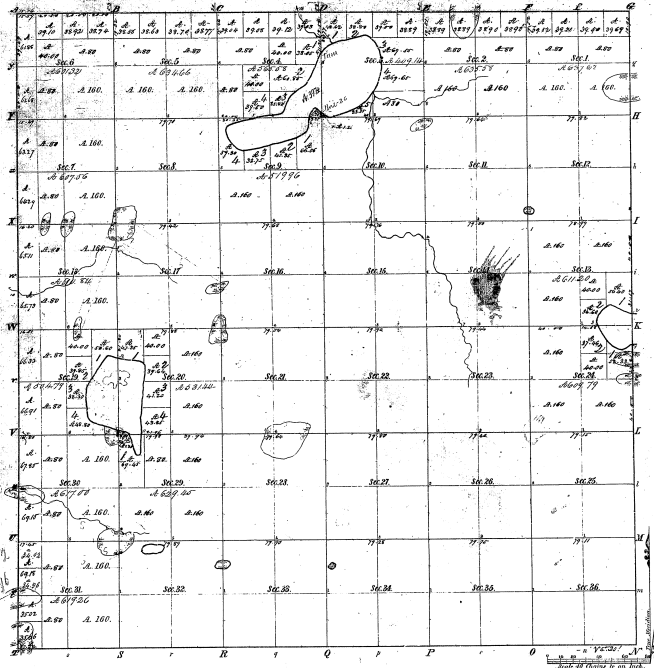

Milestones of Section			
31-91
31-96




