


Township of 30

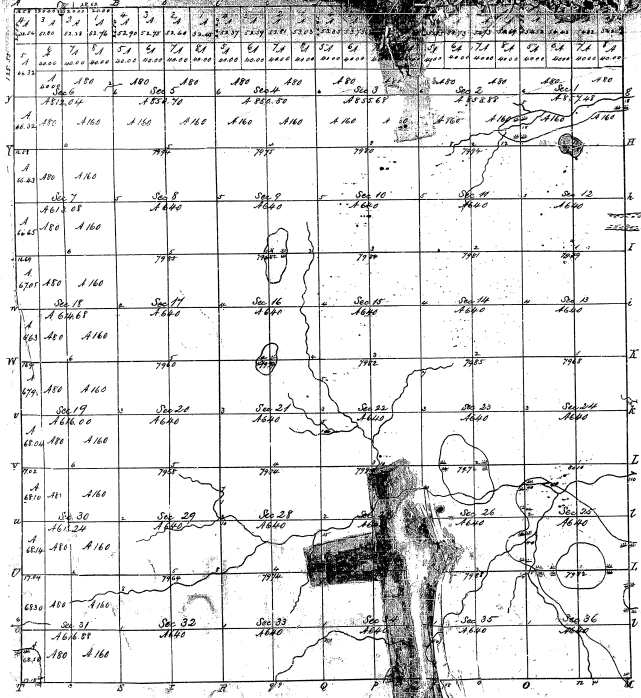

9109

Number of Acres


Scale of Chain 66 to a Foot

