


Township N. 20 N., Range N. 9 West Mer. (Mia.)

22167-25 974

Michigan

11-4

11

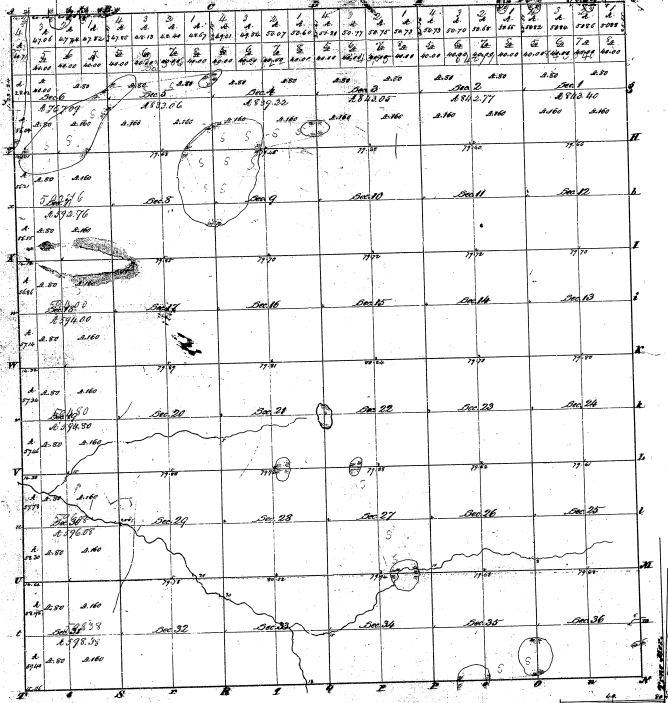

Field number of books 23,911,61

Survey	By Whom Surveyed	Date of last Work	Book & Page	When Surveyed	When Examined

The above made of books No. 23,911,61, of Camp N. 9 W. of the Principal Meridian, Michigan, is correct, conformable to the field notes of the survey, and is filed in this office, which have been examined and approved.

Surveyor General's Office
 L. Mearns
 December 20, 1838

P. Searcy
 Town Clerk