21-14

Township No. 27. N. Range No. 3. E. Mer. Mich.

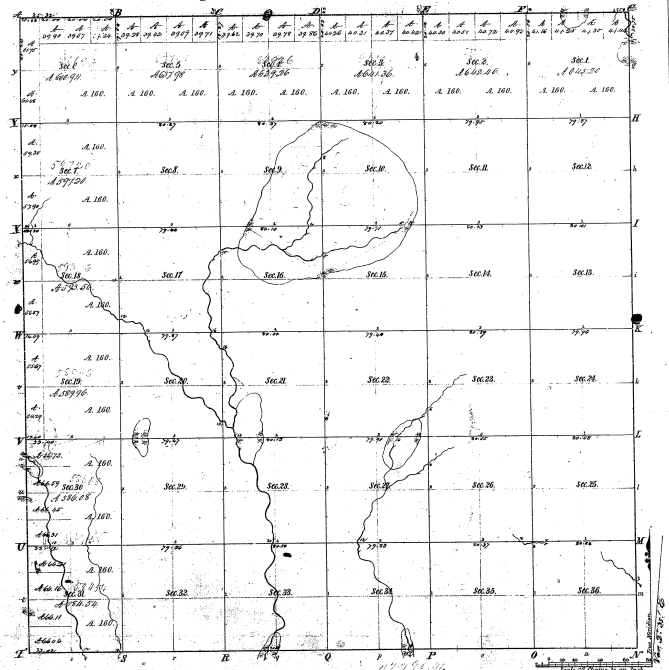

Meanders of							
Posts	Courses	Ch.s Lk.s	Posts	Courses	Ch.s Lk.s	Posts	Courses	Ch.s Lk.s

21-14

Total number of Acres 22,798.46

Surveys Designated	By Whom Surveyed	Date of Contract	Amount of Surveys	When Surveyed	When pd. for and ch.d in the Sur.r Gen.l acct.
Township lines	[illegible]	March 29th 1839	M. 42 Ch.s 69 Lks. 33	2nd qr. 1839	
Subdivisions	William M. Harvey	May 24th 1839	59. 50. 69	4th qr. 1839	2nd qr. 1840

The above Map of Township No. 27 North of Range No. 3 East of the Principal Meridian Michigan is strictly conformable to the field notes of the survey thereof on file in this Office which have been examined and approved.

Surveyor General's Office
Cincinnati, April 24th 1840

E. S. Hawkins Sur. Genl.

16