Resurvey

Township No. 29 N. Range No. 4 W. Mer. Mich.

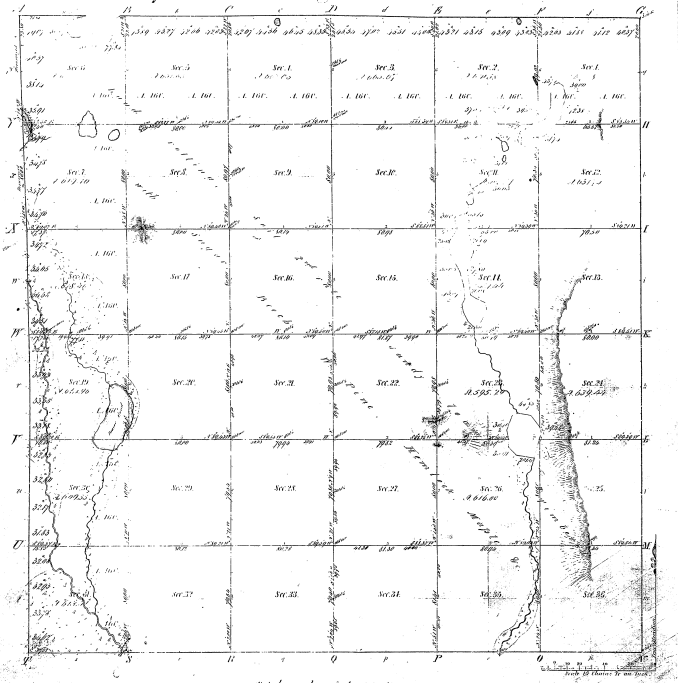


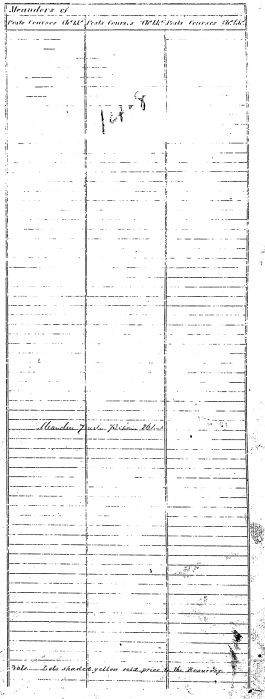

Meanders Public Platform Lake

Note — Lots shaded yellow sold prior to the Resurvey

Total number of Acres 22,185.87

Surveys Designated	By Whom Executed	Date of Contract	Amount of Surveys	When Accepted	Plats Rec'd
Township Lines	Jared Mallett	April 4th 1839	1413.16	1839	Dec 30 and Jan 6 1840

The above Map of Township No. 29 North of Range No. 4 West of the Principal Meridian of Michigan is hereby approved to be filed with the field notes of the survey thereof on file in this Office, which have been examined and approved.

Surveyor General's Office
Detroit June 8th 1841

Sam'l McKinney
Surveyor General

14-8