18-35

Township No. 31 N. Range No. 4 W. Mer. Mich.

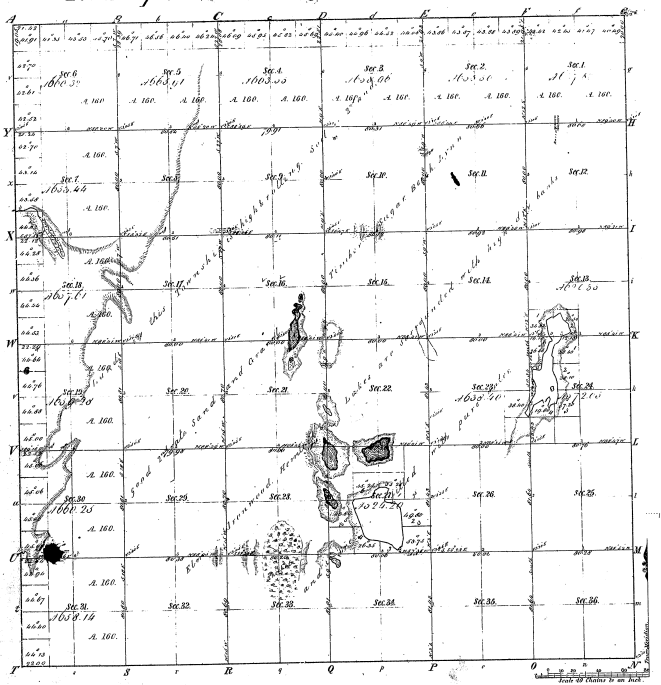

Meanders of							
Posts	Courses	Ch. Lks.	Posts	Courses	Ch. Lks.	Posts	Courses	Ch. Lks.

Total number of Acres 23035.70

	Surveys Designated	By Whom Surveyed	Date of Contract	Amount of Surveys	When Surveyed	When pr. Ser. and ch. in the Sur. Gen. Ls. acct.
	Township lines	John Mitchell	Jan. 24. 1840	11 03 00	2nd Quar. 1840	
	Subdivisions	Austin Burt	April 19 1850	65 06 30	3rd Quar. 1850	

The above Map of Township No. 31 North of Range No. 4 West of the Principal Meridian Michigan is strictly conformable to the field notes of the survey thereof on file in this Office, which have been examined and approved.

Surveyor General's Office.
Detroit Dec. 23. 1850 } Charles Noble Spec. Gen.