


Township N. 5 North, Range XIV West Mer. (Mic. Tm.)

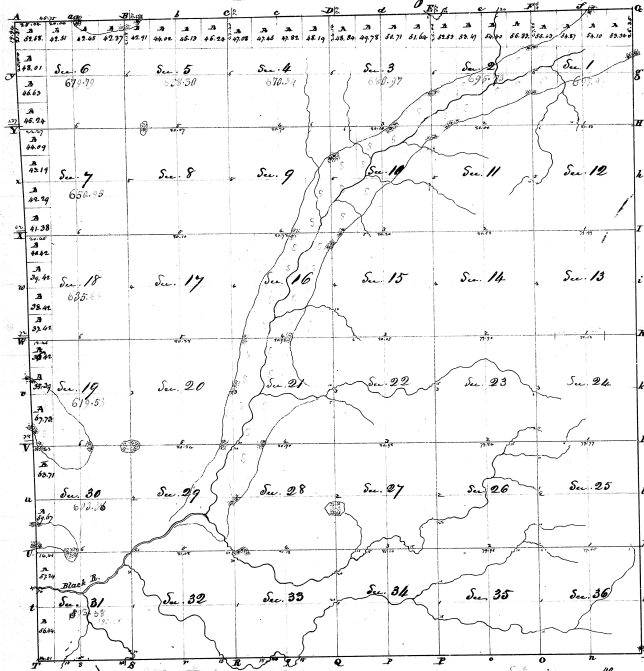

Survey Range	By whom	Date of Original Survey	When Surveyed	When Re-surveyed
Range 14	Wm. B. Smith	12 Nov. 1830	1830	1832
Range 15	Wm. B. Smith	28 " 60. 14. 61	"	3 ^d 9 th 1833

The above title of Township N. 5 North of Range N. 14 West of the Meridian which is nearly conformable to the field notes of the survey thereon, on file in this office, which have been examined and approved.
 Surveyor General's Office
 Cincinnati 15th 4th 1833
 M. T. Williams
 Sur. Gen.

8-22