


Township N. V North, Range N. XVI west Mer. (Mic. Ter.)

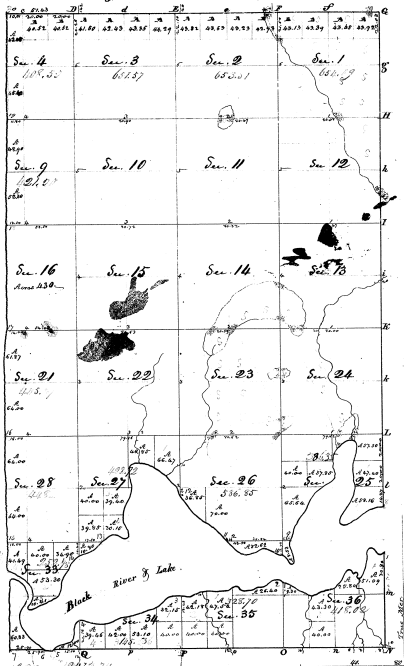

Scale of 40 chains to an inch

Surveyor's Name	Order	Date of Plat	Commence	Section	Plat No.
James W.	12 Nov. 1830
James W.	18. "
James W.	19. "

The above plat of Township N. V North, Range N. XVI west Mer. is hereby confirmed to be the full and true plat of the survey thereof, as filed in this Office, and that have been examined and approved by the Surveyor General of this Office.

Wm. T. McManis
Surv. Genl.

111
8-2-31