


Township N. VII North, Range N. XIV West Mer. (Mic. Lon.)

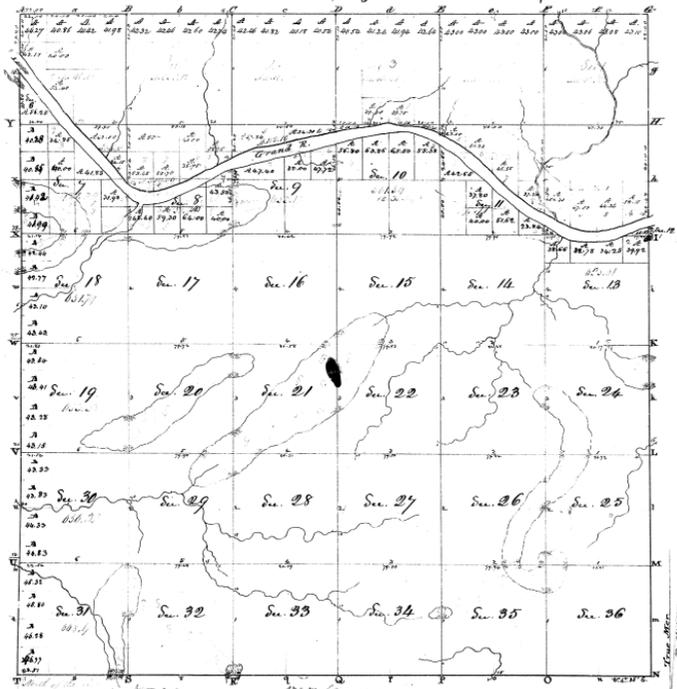

Boundaries of Grand River South Side

1	0.30	18.60
2	0.30	18.60
116  
8-14

Number of acres 1871.6


The above description of Township N. VII North of Range N. 14 West of the Meridian, Michigan, is as actually shown on the field notes of the survey thereof on file in the office, which have been examined and approved.

Surveyor General's Office  
 Dubuque Sept. 8<sup>th</sup> 1838  
 M. T. Williams  
 Sur. Gen.