Township N.° VII North, Range N.° XVI West Mer. (Mic. Ter.)

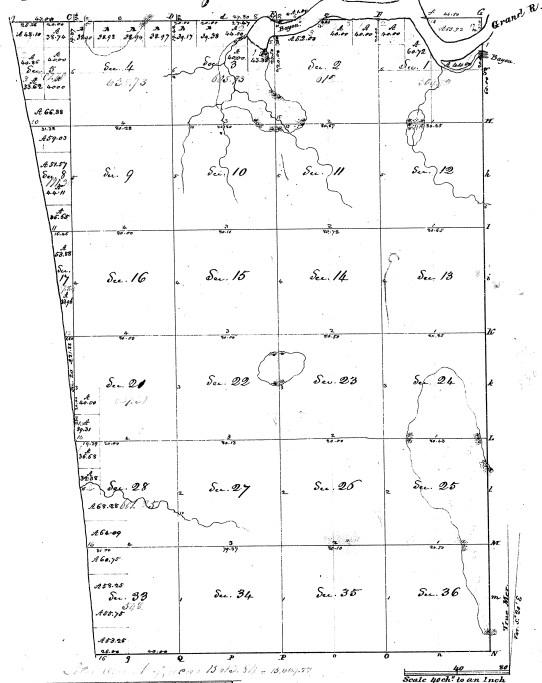

Meanders of Grand River	
S. bank down	
In Section 4.	
Beginning	C. M.
1.	S 51° W. 18.50
	West 16.50 to Bayou
	S 51° W. 13.00
	N 74° W. 4.50
	N 23° W. 23.13 to North boundary Township
Meanders of Bayou	
2.	S 60° W. 17.00 in Sec. 3.
	S 69° W. 24.00
3.	S 70° W. 8.00
	S 54° W. 6.00 in Sec. 3.
	S 12° W. 7.00
	N 86° W. 16.00
	N 41° W. 5.50
	N 36° W. 9.00
4.	N 23° W. 3.47
5.	N 36° E. 1.17 to point between Sec 2 & 3
	N 87° E. 16.50 in Sec. 3.
Begin Lake down stream	
14.	S 21° W. 15.00
	S 66° W. 8.50
	West 9.00
	N 24° W. 17.00
15.	N 16° W. 15.50

Surveys Made prior to the	By whom Surveyed	Date of Contract	Amount of Surveys &c.	$	Returned to the Surveyor Gen.l	Returned to the Office
Boundaries	C. Lyon	12 Nov. 1830				
Subdivision	C. Britton	R. " "	53. 04. 21	May 1832	2 Sept. 1833	
E. of Main Meridian Line	W. Brookfield	W. Sept. 1834	24. 70	1st qr. 1833	3 Dec. 1838	
Meanders	John Mullett	4th Aug. 1835	58. 30	4th qr. 1833	4th qr. 1837	

The above Map of Township N.° 7 North of Range N.° 16 West of the Michigan Meridian Mic. is strictly conformable to the field Notes of the Survey thereof, on file in this Office, which have been examined and approved.

Surveyor Generals Office
Cincinnati Oct 6 1843

M. T. Williams
Surv. Gen.l

8-16

16