Mullett 8-14-11 Mich. 2

Michigan

8-11

Township No. 8 N, Range No. 14 West Mer. (Mich.)

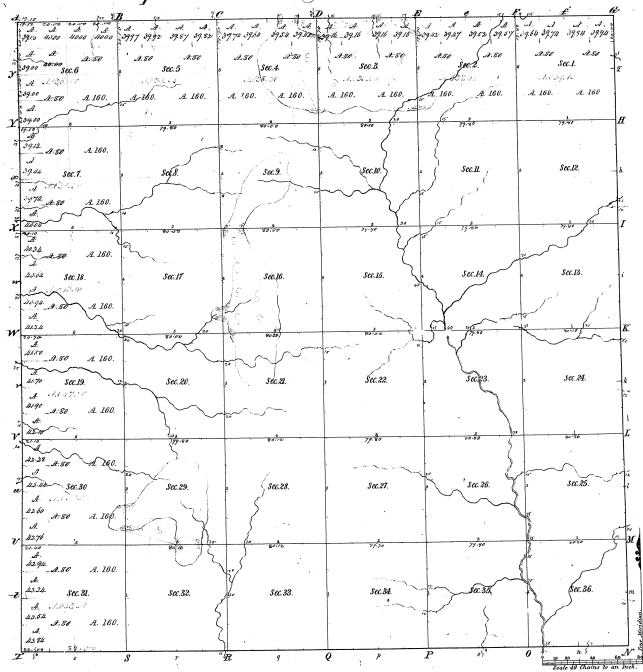

Meanders of									
Posts	Courses	Ch. Lk.	Posts	Courses	Ch. Lk.	Posts	Courses	Ch. Lk.

8° 11

Total number of Acres 23,080.08

Surveys Designated	By Whom Surveyed	Date of Contract	Amount of Surveys	When Surveyed	When Sup. Gen. Ins. and Ins. Sup. Gen. Ins.
Township lines	N. P. Rockefield	31st Sept. 1836	1st 24 Oct. 1837	1st 3rd 1838	3rd 1838
Subdivisions	John Mullett	4th Aug. 1837	60 01 90	1st 1837	4th 1837

The above Map of Township No. 8 North, of Range No. 14 West of the Principal Meridian Michigan is strictly conformable to the field notes of the survey thereof on file in this Office, which have been examined and approved.

Surveyor General's Office,
Cincinnati, Dec. 23. 1837

[signature] Sur. Gen.