Township No. 33 N. Range No. 3 E. Mer. Mich.

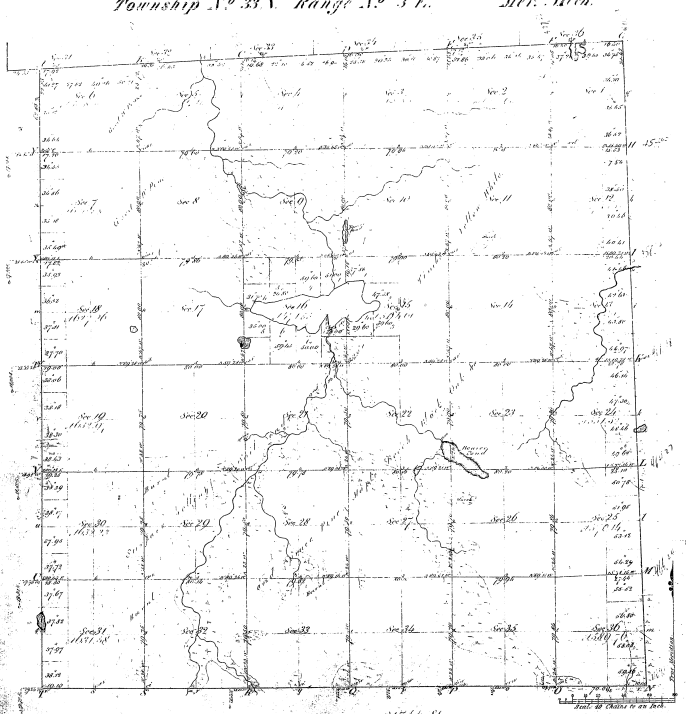

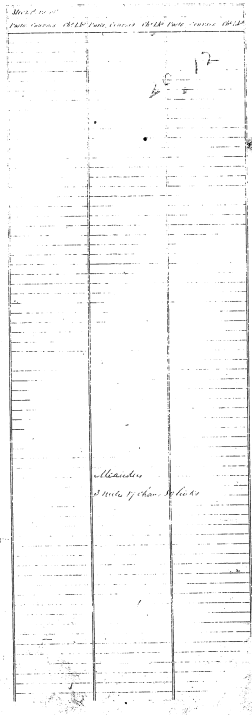

Total number of Acres 21744.81

Surveys Designated.	By Whom Surveyed.	Date of Contract.	Amount of Surveys M.	Ch.	Lks.	When Surveyed.	When Changed in the Surv. Genl's Ofc.
Township lines.	John Harrington	Jany. 18. 1846	6	111	44	1st Quar. 1846	
[illegible]	[illegible]	April 19. 1850		79	10	2d Quar. 1850	
[illegible]	[illegible]	Sept. 6. 1851				4th Quar. 1851	
	G. H. Cannon	Sept. 6. 1851	61	12	60	4th Quar. 1851	

The above Map of Township No. 33 North of Range No. 3 East of the Principal Meridian, Michigan is strictly conformable to the field notes of the survey thereof on file in this Office, which have been examined and approved.

Surveyor General's Office
Detroit, February 1852

Charles Holde Sur. Genl.

70-13