


RESOLUTION  

M<sup>o</sup>: Mich.

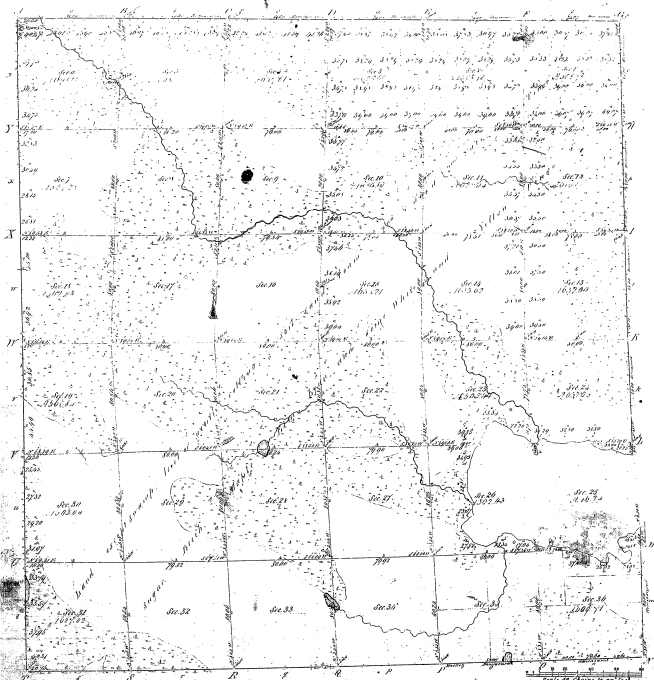

Boundaries  
Two corners of the road shown on the map

Number of acres 42 chains & links

20-16

Total number of Acres 21 1/2 1/2			

The above Map of Township N<sup>o</sup> 33 1<sup>st</sup> Range W<sup>o</sup> 7<sup>th</sup> East of the Principal Meridian of Michigan is truly and correctly surveyed and approved of the Surveyors of this office which have been examined and approved  
 Surveyors General Office  
 A. C. Comstock  
 26<sup>th</sup> Feb. August 1852