Resurvey

Township No. 34 N. Range No. 4 E. Mer. Mich.

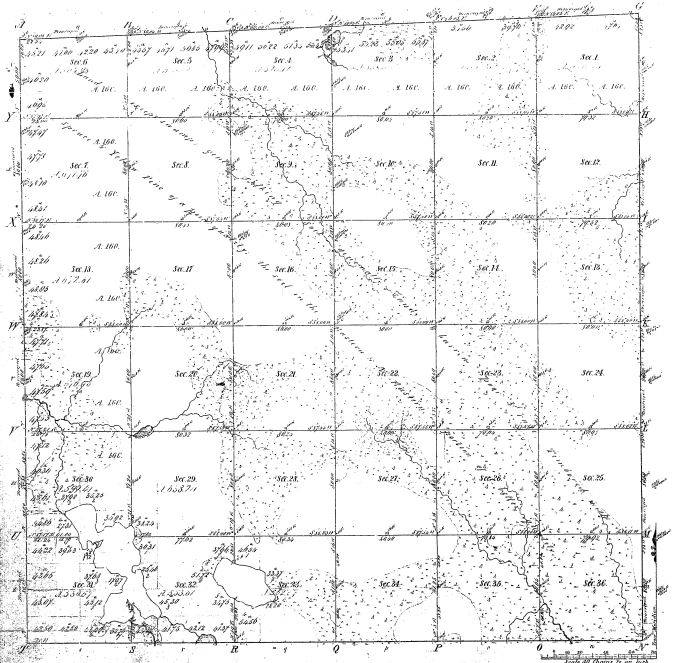

Meanders of					
Feet Courses	Ch.s Lk.s	Feet Courses	Ch.s Lk.s	Feet Courses	Ch.s Lk.s

Total number of Acres 22,175.99

Surveys Designated	By Whom Surveyed	Date of Contract	Amount of Surveys	When Surveyed	When p.d for and ch.d in the Int. Gen.l Cor.s
Exterior Lines	John Hodgson	Sept. 15. 1840	M. Ch.s Lk.s 4. 01. 11.	2nd Quar. 1840	
Subdivisions	[illegible]	Instructions	04. 23. 43	[illegible]	
Base Merid.n	Alfred Millard	Instructions	5. 72. 50		

The above Map of Township No. 34 North of Range No. 4 East Principal Meridian of Michigan is strictly conformable to the field notes of the surveys thereof on file in this Office which have been examined and approved.

Surveyor General's Office
Detroit December 1 1840

Leander Ackerman Spec. Agent

Corr.d Copy made