


Resurvey  
Township 1° 31' N. Range 1° 06' E. Mex. Mich.

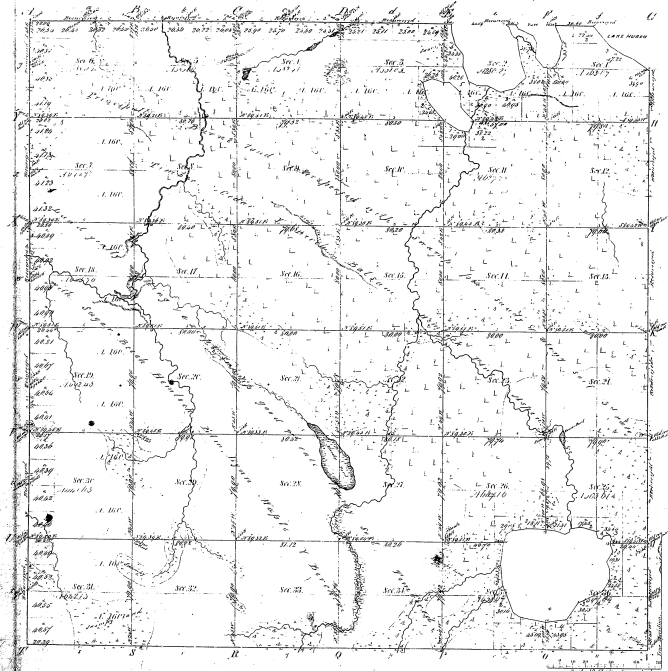





Total number of Acres 21579.74

Survey Designated	By Whom Surveyed	Date of Conduct	Amount of Survey	When Surveyed	When Surveyed
Township 1° 31' N. Range 1° 06' E.	J. H. Rogers	Jan 15 1850	8 55 56	1850	1850
Subdivisions		Jan 15 1850	8 55 56	1850	1850
X.M. Co. M. Chicago		Jan 15 1850	5 39 50	1850	1850

The above map of Township 1° 31' North of Range 1° 06' East of the Principal Meridian of Michigan is truly conformable to the field notes of the survey thereof, and the order thereon which have been examined and approved.

Surveyor General J. H. Rogers  

