Resurvey

Township N.° 38 N. Range N.° 1 E. Mer. Mich.

19-27

LAKE HURON

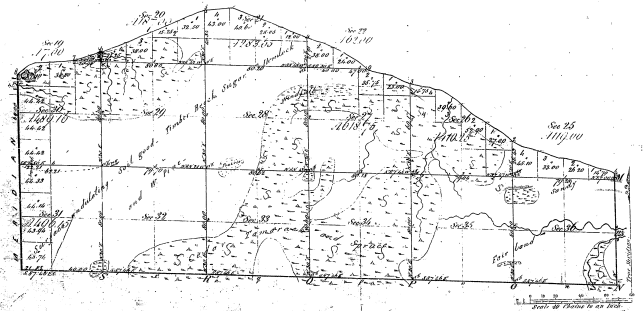

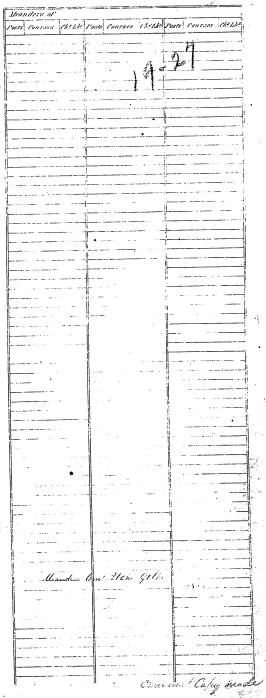

Total number of Acres 1,132.96

Surveys contracted	By Whom Surveyed	Date of Contract	Number of Surveys Rejected	When Surveyed	When Returned to the Surveyor Gen.l's office
Original Survey of Township	John Hodgson	June 18 1846		2nd Quar. 1846	
Resurveying Town Lines	Geo. H. Cannam	October 5 1852	4	4th Quar. 1852	
and Meanders	George H. Cannam	October 5 1852	24	4th Quar. 1852	

The above Map of Township 38 North of Range 01 East of the Principal Meridian is hereby approved and accepted as conformable to the field notes of the Survey thereof now filed in this Office, which have been examined and approved.

Surveyor General's Office Detroit Mich. October 18th 1854

Sam.l D. Cholmeley Surv.r Genl