Re Survey

Township. Nº 21 N. Range Nº 3 W. Mer. Mich.

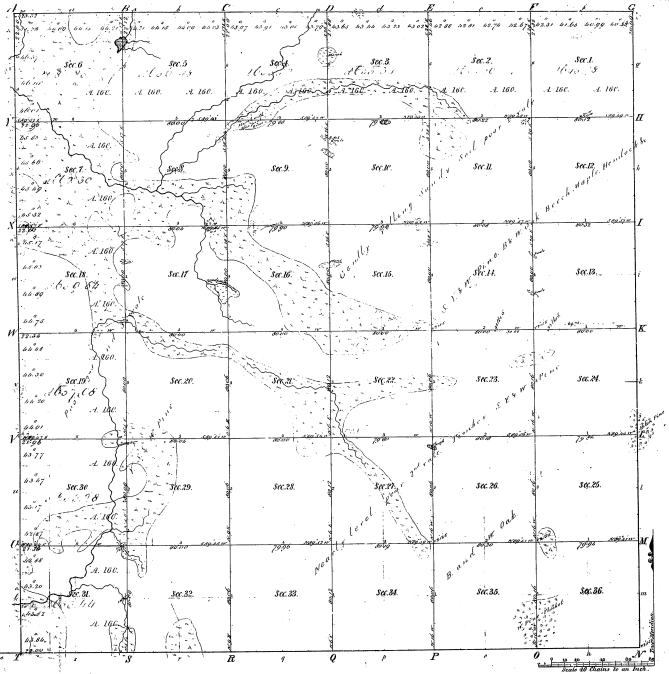

Meanders of

Public Courses	Var. E.	Public Courses	Var. E.	Public Courses	Var. E.

14-

14-39

Total number of Acres 23220.01

Surveys Designated	By Whom Surveyed	Date of Contract	Amount of Surveys	When Surveyed	When the Surveys were and shall be the Surr. Gen.ls Cert.s
Township lines	John Mack	Nov.r 7th 1835	24 25 16	2nd Quar. 1837	
Subdivisions	William A. Burt	Dec.r 28. 1841	66. 22. 00	3rd Quar. 1842	

The above Map of Township Nº 21 North of Range Nº 3 West of the Principal Meridian Michigan is strictly conformable to the field notes of the survey thereof on file in this Office, which have been examined and approved.

Surveyor Generals Office
Detroit April 9 1849

Mack Pitch
Surr. Genl