Resurrey

Township No. 23 N. Range No. 3 W. Mer. Mich.

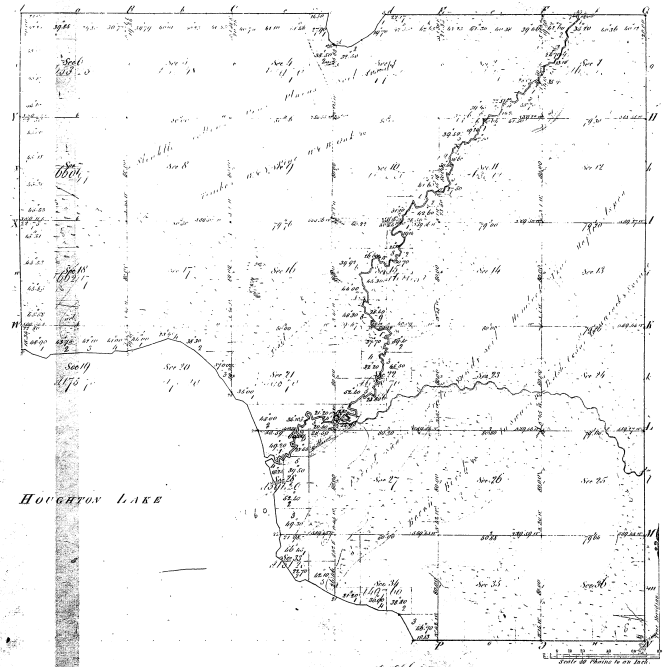

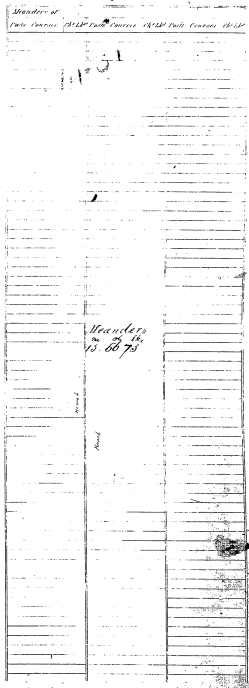

Total number of Acres 18,566.79

Surveys Contracted.	By Whom Surveyed.	Date of Contract.	Amount of Surveys M. Chs. Lks.	Whn. Surveyed.	Whn. Chkd. in the Surv. Genl. Ofc.
Township Lines.	John Brink	Nov. 16 1836	8. 18. 73	1st Quar. 1838	
Subdivision.	Arlene Curtis	April 20 1852	65. 18. 74	1st Quar. 1852	

The above Map of Township No. 23 Sectns. of Range No. 3 West of the Principal Meridian Michigan, is strictly responsible to the field notes of the survey thereof on file in this Office, which have been examined and approved.

Surveyor General's Office, Chicago, Ill. Jan. 1st 1853

Chas. Gould
Asst. Genl.

14-31

16