



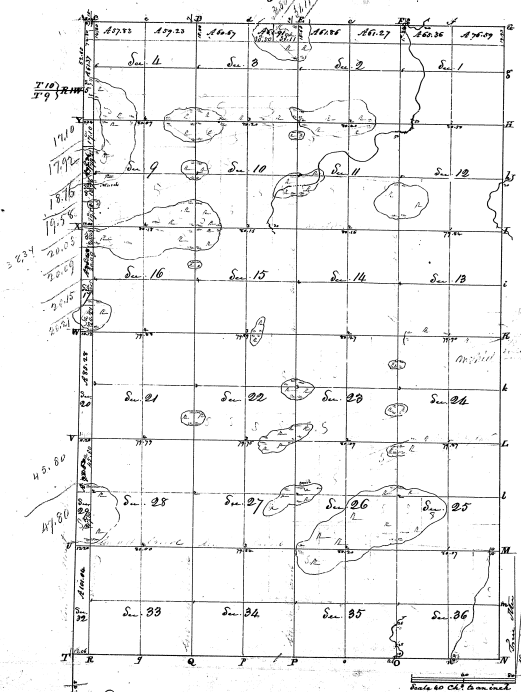

Contents		Sections	Area	Acres
Pl. No. 1			75	17
Pl. No. 2			80	
Pl. No. 3			60	16
Pl. No. 4			80	
Pl. No. 5			320	
Pl. No. 6			61	27
Pl. No. 7			70	
Pl. No. 8			67	18
Pl. No. 9			80	
Pl. No. 10			320	
Pl. No. 11			80	
Pl. No. 12			61	91
Pl. No. 13			80	
Pl. No. 14			60	
Pl. No. 15			67	
Pl. No. 16			80	
Pl. No. 17			320	
Pl. No. 18			61	37
Pl. No. 19			80	
Pl. No. 20			62	36
Pl. No. 21			80	
Pl. No. 22			60	
Total			18,714	38

24-8  
29-8

Surveyed in April 1831, by Robinson Thomas, D. S.  
 Surveyor General's Office, S. M. T. Williams  
 Cincinnati, May 25, 1832.