


Township N. IX North, Range N. III East Mer. (M.T.M.)

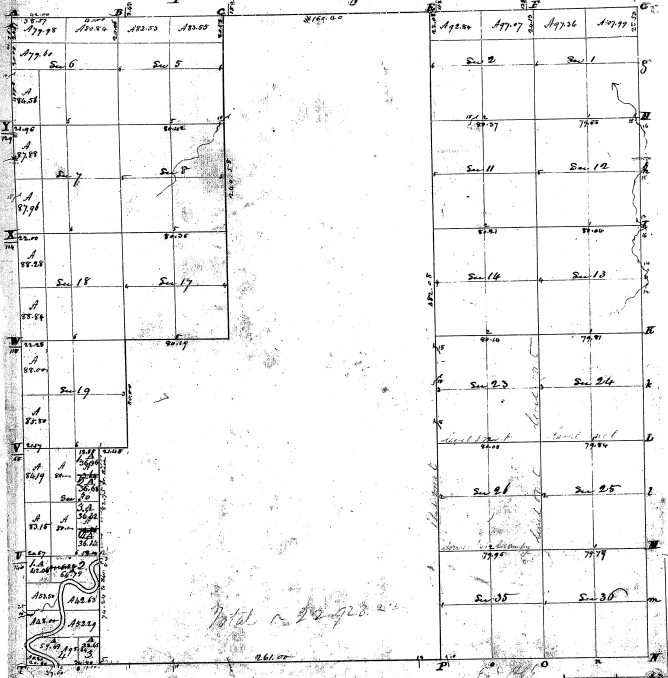

29-6


29-6

 Done this 28th day of April 1852  
 Wm. Hamblin


Mer. (Mich.)

30

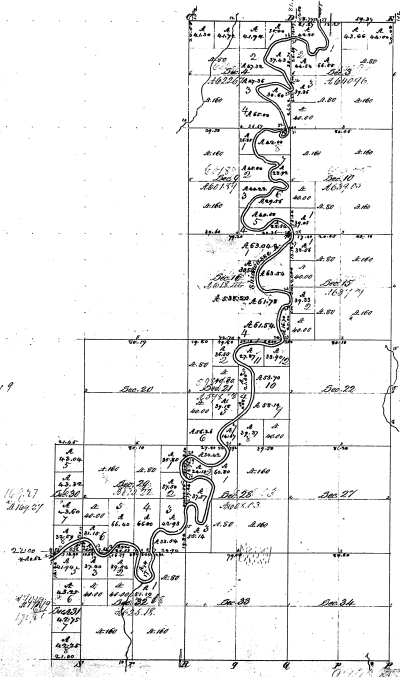

29-6

29-6

Total number of Acres 9743.10




*Carleins*