



113

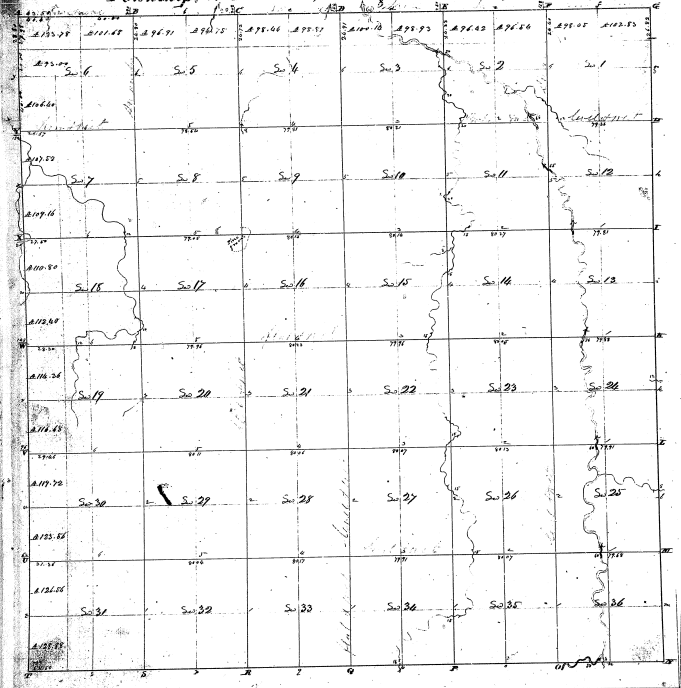

29-5

29-5

Consent to a contract with and instructions from Board of the Surveyors General of the United States, bearing date the 11th day of March 1823, and to accept the same, and do hereby state that the said Board have been both notified and assigned, as are represented on said piece and described in the files 1823, and that the same have been put into the hands of the Surveyors General Office - both for the 30th day of April 1823.

W. Hambleton S. J.