




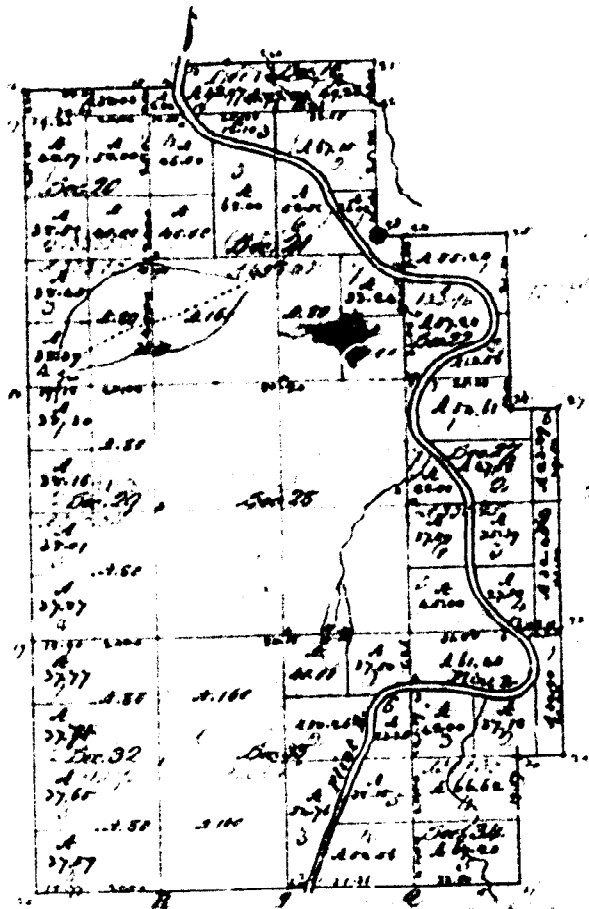


		Total number of acres	
When Surveyed	Date of Contract	When Surveyed	When changed in the Survey
John M. Wallace	Feb. 16. 1839	1.72 .37	2.77 .1839
		20.78 .55	

The above Map of Township N. 10 N. Range N. 5 E. East of the Principal Meridian Michigan is a copy of the original of the survey thereof on file in this Office under said name.

Surveyor General's Office
Cincinnati, May 23. 1840.

G. Stearns