


Township N. 11. North, Range N. 11 East 4th. (Misc. Sec.)

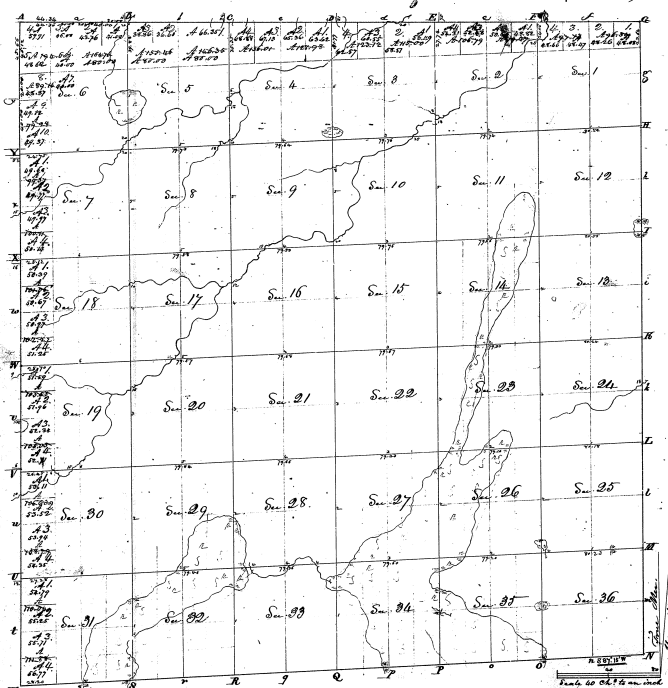

Surveyed in January & February 1881, by Henry Cole, L.S.
 The above Map of Township N. 11 N. of Range N. 11 E. of the principal
 Meridian (Misc. Sec.) is hereby confirmed to be the field notes of the Survey
 through people in this Office, which have been examined & approved.
 Survey General's Office, S. M. T. Williams
 Washington, D.C. 3/18/81

Contents.			

12
S.M.S.